



March 22, 2023

## MEMORANDUM

**FOR :** The Regional Executive Director  
MIMAROPA Region

**THRU :** The Assistant Regional Director for Technical Services

**FROM :** The OIC, PENR Officer  
Oriental Mindoro

**SUBJECT :** **SUBMISSION OF PERFORMANCE EVALUATION AND ASSESSMENT REPORT OF 40 CERTIFICATE OF STEWARDSHIP CONTRACTS (CSCs) WITHIN THE MUNICIPALITY OF BANSUD AND GLORIA, ORIENTAL MINDORO FOR 1<sup>ST</sup> QUARTER TARGET CY 2023**

Submitted is the report of CENRO Roxas on the performance evaluation and assessment 40 CSC located at So. Sitio Dalayan, Manguyang, Gloria, and Sitio Dalayan, Brgy. Conrazon Bansud Oriental Mindoro. The assessment was conducted last March 8-9, 2023.

Based on the result of evaluation and assessment of 40 CSCs, the following are the findings observed by the Technical Working Group (TWG):

1. The CSC areas were within contested area of Barangay Manguyang , Gloria and Brgy. Conrazon, Bansud, Oriental Mindoro;
2. CSC areas evaluated and assessed at So. Dalayan, Barangay Manguyang, Gloria and Sitio Dalayan, Barangay Conrazon, Bansud were within CADC 123 of Tadyawan- Mangyan;
3. CSC areas assessed and evaluated have no forest occupants;
4. Banay-banay Batino and other growth forest were prevalent in the area;
5. Sitio Dalayan, Barangay Conrazon Banus was within by reforestation project under NGP of CY 2017; and
6. There were no improvements and developments introduced by the CSC Holders in the area with sporadic growth of naturally grown trees in the area.

Therefore, the TWG of CENRO Roxas has recommended the cancellation of the 40 CSC holders due to the above findings and unsatisfactory management and protection of the covered forestland.

Attached are the pertinent documents on the performance evaluation contained on the compact disc (CD) of e-copy of the said report.

For information and record.

  
**ALAN L. VALLE**





Republic of the Philippines  
Department of Environment and Natural Resources  
MIMAROPA Region  
**Community Environment and Natural Resources Office**  
Camia St., San Mariano, Roxas, Oriental Mindoro  
Contact No.: 0917 876 9985 / 0917 169 0232  
VOIP: (043) 289-7118  
Email: cenroroxasormindoro@denr.gov.ph

---

March 15, 2023

**MEMORANDUM**

**FOR** : The Regional Executive Director  
DENR MIMAROPA Region  
1515 DENR by the Bay Bldg.  
Roxas Blvd., Brgy. 668, Ermita, Manila

**THRU** : The OIC-PENR Officer  
Suqui, Calapan City

**FROM** : The CENR Officer  
San Mariano, Roxas, Oriental Mindoro


**SUBJECT** : **SUBMISSION OF PERFORMANCE EVALUATION AND ASSESSMENT REPORT OF FORTY (40) CERTIFICATE OF STEWARDSHIP WITHIN THE MUNICIPALITY OF BANSUD AND GLORIA, ORIENTAL MINDORO FOR FIRST (1<sup>ST</sup>) QUARTER TARGET CY 2023**

Submitted herewith is the Performance Evaluation and Assessment Report of DENR-CENRO Roxas, Oriental Mindoro for 1<sup>st</sup> quarter target CY 2023 under Integrated Social Forestry Program.

Relative to this, the DENR-CENRO Roxas, Technical Working Group together with the Barangay LGU representatives evaluated and assessed forty (40) Certificate of Stewardship Contract conducted at Sitio Dalayan Barangay Manguyang, Conrazon and Sitio Dalayan Barangay Conrazon, Bansud, Oriental Mindoro.

Please see attached CD and documents pursuant to FMB Technical Bulletin No. 11, DMC No. 1993-21, DMC No. 1993-23 and Memorandum from Undersecretary for Field Operations dated November 28, 2013.

For information and record.

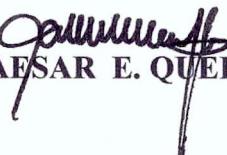  
**ENGR. CAESAR E. QUEBEC**



March 13, 2023

## MEMORANDUM

**FOR :** **The CENRO**  
San Mariano, Roxas, Oriental Mindoro

**FROM :** **The CBFM Technical Working Group**  
San Mariano, Roxas, Oriental Mindoro

**SUBJECT :** **COMPLETED STAFF WORK RE: PERFORMANCE EVALUATION AND ASSESSMENT OF 40 CERTIFICATE OF STEWARDSHIP CONTRACT (CSC) CONDUCTED ON FIRST QUARTER OF 2023 LOCATED AT SITIO DALAYAN, BRGY, MANGUYANG, GLORIA, AND SITIO DALAYAN BRGY. CONRAZON, BANSUD, ORIENTAL MINDORO.**

### I. BACKGROUND INFORMATION

This activity was guided by previous memorandum from Regional Executive Director dated April 19, 2021 which reiterates that the submission of CSC Performance Evaluation report will follow the FMB prescribed format including policy proposal/s on CSC which deemed necessary to be crafted or revised/amended based on current realities in the field which also refers to memorandum from the Assistant Secretary for Policy, Planning, and Foreign Assisted and Special Projects, and Director, in concurrent capacity dated June 24, 2021 relative to the submission of summary result on the Performance Evaluation of Certificate of Stewardship Contracts (CSCs) and advisory from Provincial Environment Natural Resources Office regarding submission of Performance Evaluation and Assessment Report of all CSC holders in Completed Staff Work (CSW) to include recommendations/ actions to be taken, identified issues and concerns on the part of CSC holders in the implementation of activities, and their compliance with existing rules and regulations. Also, this activity was guided by the following guidelines to properly facilitate the renewal, cancellation and transfer of CSC's.

1. DMC No. 1993-21-Revised Procedures on the Conduct of Performance Evaluation of Stewardship Agreement, Cancellation and Compensation of the Holders Thereof;
2. DMC No. 1993-23-Revised Procedures on the Transfer of Certificate of Stewardship (CS) to the Next-of-Kin of the Holders Thereof;
3. Memorandum from Undersecretary for Field Operations dated November 28, 2013 Renewal and cancellation of Certificate of Stewardship Contract (CSC; and



4. FMB Technical Bulletin No.11-Supplemental Guide on the Evaluation of Certificate of Stewardship Contracts.

## II. ACTION TAKEN

In compliance to the above mentioned memoranda and guidelines regarding submission of Performance Evaluation and Assessment Report of all CSC holders in Completed Staff Work to include recommendations/ actions to be taken, identified issues and concerns on the part of CSC holders in the implementation of activities, and their compliance with existing rules and regulations. Also, in the interest of the service and in order to facilitate the conduct of evaluation and assessment of CSC Holders within CENRO-Roxas jurisdiction for the year 2023 and in compliance to the Memorandum signed by CENR Officer – Engr. Caesar E. Quebec dated February 07, 2023 wherein Technical Working Group were created for the Evaluation and Assessment of CSC Holders. The said activity was conducted for 24 CSC Holders at Sitio Dalayan, Brgy. Manguyang, Gloria on March 08-09, 2023 and 16 CSC Holders at Sitio Dalayan Brgy. Conrazon, Bansud Oriental Mindoro on March 09, 2023.

## III. FINDINGS AND OBSERVATIONS

Upon the conduct of ground validation for the performance evaluation and assessment of expired Certificate of Stewardship Contract, the following were noted and observed:

- The CSC area was within contested area of Barangay Manguyang, Gloria vs. Barangay Conrazon, Bansud Oriental Mindoro.
- CSC areas evaluated and assessed at Sitio Dalayan, Barangay Manguyang, Gloria and Sitio Dalayan, Barangay Conrazon, Bansud was within CADC123 of Tadyawan – Mangyan.
- CSC Holders assessed and evaluated have no forest occupants.
- Banay-banay, Batino and other secondary growth forest were prevalent in the area.
- Sitio Dalayan, Barangay Conrazon, Bansud was covered by reforestation project under National Greening Program year 2017.
- There were no improvements and developments introduced by the CSC Holders in the area with sporadic growth of naturally grown tree in the area.

## IV. RECOMMENDATIONS

Performance and assessments were based on the following criteria:

1. Organizational/Community Involvement



2. Area Development which includes Nursery Operations, Plantation Establishment and Plantation Care and Maintenance
3. Protection and Conservation of Forest Resources

The result of evaluation for 24 CSC holders located in Sitio Dalayan, Barangay Manguyang, Gloria, Oriental Mindoro had a numerical rating of 45% to 53% with an average of 47% while 46% to 49% in Sitio Dalayan, Barangay Conrazon, Bansud Oriental Mindoro with an average of 47 %. It shows that the Performance of CSC holders were unsatisfactory in terms of management and protection of portion of forestland awarded to them. Moreover, the CSC areas fall within CADC123 Tadyawan-Mangyan. Therefore, the Technical Working Group (TWG) recommended for cancellation of the Certificate of Stewardship Contract.


  
**ANABELLE R. CASTILLO**  
Forest Technician II

  
**IRENEO HAMLET J. EUSTAQUIO II**  
Forest Technician II

  
**ACE C. GLORIA**  
Forest Technician I

  
**LARRY E. HERILLA**  
Forest Technician I

  
**JERRY R. MANUCAY**  
ECOMS I

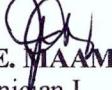  
**MARCELINA E. MAAMO**  
Forest Technician I

  
**MARIELLE M. NGABIT**  
Forester I/CBFM Desk Officer

  
**JOSE T. MONTECALVO**  
SEMS/Chief, Conservation and Development Section

SUMMARY REPORT ON THE PERFORMANCE EVALUATION OF CERTIFICATE OF STEWARDSHIP CONTRACT (CSC)

| OFFICE | NAME OF CS HOLDERS/NUMBER OF CSC EVALUATED | AREA (has.) | LOCATION  | DATE ISSUED       | NUMERICAL RATING | RESULT OF EVALUATION   |   | ACTION TAKEN BY THE REGION (RENEW/CANCEL/ FOR RE-EVALUATION) | REMARKS (IF CSC WAS TRANSFERRED, INCLUDE THE NAME TO WHOM IT WAS TRANSFERRED AND HIS/HER RELATIONSHIP TO THE CS HOLDER) |
|--------|--|-------------|---|-------------------|------------------|--|---|--|---|
|        |  |             |   |                   |                  | RECOMMENDATION (FOR RENEWAL/FOR CANCELLATION/ FOR RE-EVALUATION) | REMARKS (IF CSC WAS TRANSFERRED, INCLUDE THE NAME TO WHOM IT WAS TRANSFERRED AND HIS/HER RELATIONSHIP TO THE CS HOLDER) |  |   |
| CENRO  | 24   | 78.74       |   |                   |                  |  |   |  |   |
| Roxas  | Robert Evora/ CSC No. 028548               | 3.74        | Sitio Dalayan, Barangay Manguyang, Gloria, Oriental Mindoro | November 25, 1992 | 46%              | For Cancellation   |   | within CADC 123 of Tadyawan-Mangyan                          |   |
| Roxas  | Vicente Balmes/ CSC No. 028552             | 3.36        | Sitio Dalayan, Barangay Manguyang, Gloria, Oriental         | November 25, 1992 | 47%              | For Cancellation   |   | within CADC 123 of Tadyawan-Mangyan                          |   |
| Roxas  | Maximo Alecy/ CSC No. 028551               | 3.45        | Sitio Dalayan, Barangay Manguyang, Gloria, Oriental         | November 25, 1992 | 45%              | For Cancellation   |   | within CADC 123 of Tadyawan-Mangyan                          |   |
| Roxas  | Angel Ronkali/ CSC No. 028555              | 3.46        | Sitio Dalayan, Barangay Manguyang, Gloria, Oriental         | November 25, 1992 | 47%              | For Cancellation   |   | within CADC 123 of Tadyawan-Mangyan                          |   |
| Roxas  | Belen Salva/ CSC No. 028546                | 2.56        | Sitio Dalayan, Barangay Manguyang, Gloria, Oriental         | November 25, 1992 | 46%              | For Cancellation   |   | within CADC 123 of Tadyawan-Mangyan                          |   |
| Roxas  | Dorotea Balmes/ CSC No. 028547             | 1.46        | Sitio Dalayan, Barangay Manguyang, Gloria, Oriental         | November 25, 1992 | 46%              | For Cancellation   |   | within CADC 123 of Tadyawan-Mangyan                          |   |
| Roxas  | Faustino Saludes/CSC No. 028542            | 4.62        | Sitio Dalayan, Barangay Manguyang, Gloria, Oriental         | November 25, 1992 | 49%              | For Cancellation   |   | within CADC 123 of Tadyawan-Mangyan                          |   |
| Roxas  | Jose Salva/CSC No. 028543                  | 2.52        | Sitio Dalayan, Barangay Manguyang, Gloria, Oriental         | November 25, 1992 | 49%              | For Cancellation   |   | within CADC 123 of Tadyawan-Mangyan                          |   |
| Roxas  | Jorge Coz/CSC No. 028545                   | 3.29        | Sitio Dalayan, Barangay Manguyang, Gloria, Oriental         | November 25, 1992 | 47%              | For Cancellation   |   | within CADC 123 of Tadyawan-Mangyan                          |   |
| Roxas  | Jesus Roncali/CSC No. 028553               | 4.10        | Sitio Dalayan, Barangay Manguyang, Gloria, Oriental         | November 25, 1992 | 47%              | For Cancellation   |   | within CADC 123 of Tadyawan-Mangyan                          |   |
| Roxas  | Leon Magtibay/CSC No. 028554               | 4.39        | Sitio Dalayan, Barangay Manguyang, Gloria, Oriental         | November 25, 1992 | 47%              | For Cancellation   |   | within CADC 123 of Tadyawan-Mangyan                          |   |
| Roxas  | Melencio Magsino/CSC No. 028577            | 3.57        | Sitio Dalayan, Barangay Manguyang, Gloria, Oriental Mindoro | November 25, 1992 | 46%              | For Cancellation   |   | within CADC 123 of Tadyawan-Mangyan                          |   |
| Roxas  | Gumerindo Lipat/CSC No. 028541             | 2.93        | Sitio Dalayan, Barangay Manguyang, Gloria, Oriental         | November 25, 1992 | 46%              | For Cancellation   |   | within CADC 123 of Tadyawan-Mangyan                          |   |

SUMMARY REPORT ON THE PERFORMANCE EVALUATION OF CERTIFICATE OF STEWARDSHIP CONTRACT (CSC)

| OFFICE | NAME OF CS HOLDERS/NUMBER OF CSC EVALUATED | AREA (has.) | LOCATION  | DATE ISSUED       | NUMERICAL RATING | RESULT OF EVALUATION   |   | ACTION TAKEN BY THE REGION (RENEW/CANCEL/ FOR RE-EVALUATION) | REMARKS |
|--------|--|-------------|---|-------------------|------------------|--|---|--|---------|
|        |  |             |   |                   |                  | RECOMMENDATION (FOR RENEWAL/FOR CANCELLATION/ FOR RE-EVALUATION) | REMARKS (IF CSC WAS TRANSFERRED, INCLUDE THE NAME TO WHOM IT WAS TRANSFERRED AND HIS/HER RELATIONSHIP TO THE CS HOLDER) |  |         |
| Roxas  | Mario Gonzales/CSC No. 028540              | 2.52        | Sitio Dalayan, Barangay Manguyang, Gloria, Oriental | November 25, 1992 | 46%              | For Cancellation   |   | within CADC 123 of Tadyawan-Mangyan                          |         |
| Roxas  | Segundo Palma/CSC No. 028539               | 2.95        | Sitio Dalayan, Barangay Manguyang, Gloria, Oriental | November 25, 1992 | 53%              | For Cancellation   |   | within CADC 123 of Tadyawan-Mangyan                          |         |
| Roxas  | Vicente Roncali/CSC No. 028536             | 2.75        | Sitio Dalayan, Barangay Manguyang, Gloria, Oriental | November 25, 1992 | 48%              | For Cancellation   |   | within CADC 123 of Tadyawan-Mangyan                          |         |
| Roxas  | Crispin Vera/CSC No. 028535                | 2.92        | Sitio Dalayan, Barangay Manguyang, Gloria, Oriental | November 25, 1992 | 47%              | For Cancellation   |   | within CADC 123 of Tadyawan-Mangyan                          |         |
| Roxas  | Rustico Manalo/CSC No. 028537              | 3.01        | Sitio Dalayan, Barangay Manguyang, Gloria, Oriental | November 25, 1992 | 47%              | For Cancellation   |   | within CADC 123 of Tadyawan-Mangyan                          |         |
| Roxas  | Manuel Rances/CSC No. 028538               | 3.21        | Sitio Dalayan, Barangay Manguyang, Gloria, Oriental | November 25, 1992 | 47%              | For Cancellation   |   | within CADC 123 of Tadyawan-Mangyan                          |         |
| Roxas  | Natalio Palma/CSC No. 028538               | 3.67        | Sitio Dalayan, Barangay Manguyang, Gloria, Oriental | November 25, 1992 | 53%              | For Cancellation   |   | within CADC 123 of Tadyawan-Mangyan                          |         |
| Roxas  | Estilito Aguado/CSC No. 028544             | 3.43        | Sitio Dalayan, Barangay Manguyang, Gloria, Oriental | November 25, 1992 | 45%              | For Cancellation   |   | within CADC 123 of Tadyawan-Mangyan                          |         |
| Roxas  | Juan Ravanes/CSC No. 028549                | 3.79        | Sitio Dalayan, Barangay Manguyang, Gloria, Oriental | November 25, 1992 | 47%              | For Cancellation   |   | within CADC 123 of Tadyawan-Mangyan                          |         |
| Roxas  | Porferio Palma/CSC No. 028537              | 4.25        | Sitio Dalayan, Barangay Manguyang, Gloria, Oriental | November 25, 1992 | 49%              | For Cancellation   |   | within CADC 123 of Tadyawan-Mangyan                          |         |
| Roxas  | Felino Magtibay/CSC No. 028530             | 2.79        | Sitio Dalayan, Barangay Manguyang, Gloria, Oriental | November 25, 1992 | 47%              | For Cancellation   |   | within CADC 123 of Tadyawan-Mangyan                          |         |

EVALUATORS:

JERRY R. MANUCAY  
EcoMS I

ANABELLE R. CASTILLO  
Forest Technician II

IRENEO HAMLET J. EUSTAQUIO II  
Forest Technician II

MARCELINA F. TAMAYO  
Forest Technician I

JOSE T. MONTECALVO  
SEMS/Chief CDS

LARRY E. HERILLA  
Forest Technician I

MARIE M. NGABIT  
Forester I/EBFM/Desk Officer

ACACIO C. GLORIA  
Forest Technician I

ENGR. CAESARE E. QUEBEC  
CHIR Officer











SUMMARY REPORT ON THE PERFORMANCE EVALUATION OF CERTIFICATE OF STEWARDSHIP CONTRACT (CSC)

| OFFICE | NAME OF CS HOLDERS/NUMBER OF CSC EVALUATED | AREA (has.) | LOCATION   | DATE ISSUED       | NUMERICAL RATING | RESULT OF EVALUATION   |   | ACTION TAKEN BY THE REGION (RENEW/CANCEL/ FOR RE-EVALUATION)                               | REMARKS |
|--------|--|-------------|--|-------------------|------------------|--|---|--|---------|
|        |  |             |  |                   |                  | RECOMMENDATION (FOR RENEWAL/FOR CANCELLATION/ FOR RE-EVALUATION) | REMARKS (IF CSC WAS TRANSFERRED, INCLUDE THE NAME TO WHOM IT WAS TRANSFERRED AND HIS/HER RELATIONSHIP TO THE CS HOLDER) |  |         |
| CENRO  | 16   | 43.33       |  |                   |                  |  |   |  |         |
| Roxas  | Ben Castillo/ CSC No. 028561               | 2.87        | Sitio Dalayan, Barangay Conrazon, Bansud, Oriental Mindoro | November 25, 1992 | 48%              | For Cancellation   |   | within CADC 123 of Tadyawan-Mangyan<br>Formerly Sitio Dalayan, Manguyang, Gloria, Or. Mdo. |         |
| Roxas  | Delfin Magadia/ CSC No. 028560             | 2.90        | Sitio Dalayan, Barangay Conrazon, Bansud, Oriental Mindoro | November 25, 1992 | 48%              | For Cancellation   |   | within CADC 123 of Tadyawan-Mangyan<br>Formerly Sitio Dalayan, Manguyang, Gloria, Or. Mdo. |         |
| Roxas  | Jose Castillo/ CSC No. 028568              | 2.52        | Sitio Dalayan, Barangay Conrazon, Bansud, Oriental Mindoro | November 25, 1992 | 48%              | For Cancellation   |   | within CADC 123 of Tadyawan-Mangyan<br>Formerly Sitio Dalayan, Manguyang, Gloria, Or. Mdo. |         |
| Roxas  | Jose Iiao/ CSC No. 028567                  | 3.31        | Sitio Dalayan, Barangay Conrazon, Bansud, Oriental Mindoro | November 25, 1992 | 48%              | For Cancellation   |   | within CADC 123 of Tadyawan-Mangyan<br>Formerly Sitio Dalayan, Manguyang, Gloria, Or. Mdo. |         |
| Roxas  | Estanislao Ravano/ CSC No. 028570          | 3.26        | Sitio Dalayan, Barangay Conrazon, Bansud, Oriental Mindoro | November 25, 1992 | 46%              | For Cancellation   |   | within CADC 123 of Tadyawan-Mangyan<br>Formerly Sitio Dalayan, Manguyang, Gloria, Or. Mdo. |         |
| Roxas  | Jovito Ravano/ CSC No. 028569              | 3.29        | Sitio Dalayan, Barangay Conrazon, Bansud, Oriental Mindoro | November 25, 1992 | 47%              | For Cancellation   |   | within CADC 123 of Tadyawan-Mangyan<br>Formerly Sitio Dalayan, Manguyang, Gloria, Or. Mdo. |         |
| Roxas  | Pedro Maso/ CSC No. 028586                 | 3.38        | Sitio Dalayan, Barangay Conrazon, Bansud, Oriental Mindoro | November 25, 1992 | 47%              | For Cancellation   |   | within CADC 123 of Tadyawan-Mangyan<br>Formerly Sitio Dalayan, Manguyang, Gloria, Or. Mdo. |         |
| Roxas  | Pelagio Magsino/ CSC No. 028566            | 2.69        | Sitio Dalayan, Barangay Conrazon, Bansud, Oriental Mindoro | November 25, 1992 | 46%              | For Cancellation   |   | within CADC 123 of Tadyawan-Mangyan<br>Formerly Sitio Dalayan, Manguyang, Gloria, Or. Mdo. |         |
| Roxas  | Julian Iiao/ CSC No. 028562                | 2.48        | Sitio Dalayan, Barangay Conrazon, Bansud, Oriental Mindoro | November 25, 1992 | 47%              | For Cancellation   |   | within CADC 123 of Tadyawan-Mangyan<br>Formerly Sitio Dalayan, Manguyang, Gloria, Or. Mdo. |         |


SUMMARY REPORT ON THE PERFORMANCE EVALUATION OF CERTIFICATE OF STEWARDSHIP CONTRACT (CSC)

| OFFICE | NAME OF CS HOLDERS/NUMBER OF CSC EVALUATED | AREA (has.) | LOCATION   | DATE ISSUED       | NUMERICAL RATING | RESULT OF EVALUATION   |   | ACTION TAKEN BY THE REGION (RENEW/CANCEL/ FOR RE-EVALUATION) | REMARKS  |
|--------|--|-------------|--|-------------------|------------------|--|---|--|--|
|        |  |             |  |                   |                  | RECOMMENDATION (FOR RENEWAL/FOR CANCELLATION/ FOR RE-EVALUATION) | REMARKS (IF CSC WAS TRANSFERRED, INCLUDE THE NAME TO WHOM IT WAS TRANSFERRED AND HIS/HER RELATIONSHIP TO THE CS HOLDER) |  |  |
| Roxas  | Florentino Magsino/CSC No. 028565          | 2.18        | Sitio Dalayan, Barangay Conrazon, Bansud, Oriental Mindoro | November 25, 1992 | 46%              | For Cancellation   |   | within CADC 123 of Tadyawan-Mangyan                          | Formerly Sitio Dalayan, Manguyang Gloria, Or. Mdo. |
| Roxas  | Nelson Palma/CSC No. 028571                | 2.47        | Sitio Dalayan, Barangay Conrazon, Bansud, Oriental Mindoro | November 25, 1992 | 49%              | For Cancellation   |   | within CADC 123 of Tadyawan-Mangyan                          | Formerly Sitio Dalayan, Manguyang Gloria, Or. Mdo. |
| Roxas  | Aurora Palma/CSC No. 028572                | 2.63        | Sitio Dalayan, Barangay Conrazon, Bansud, Oriental Mindoro | November 25, 1992 | 49%              | For Cancellation   |   | within CADC 123 of Tadyawan-Mangyan                          | Formerly Sitio Dalayan, Manguyang Gloria, Or. Mdo. |
| Roxas  | Fidela Dawis/CSC No. 028573                | 3.05        | Sitio Dalayan, Barangay Conrazon, Bansud, Oriental Mindoro | November 25, 1992 | 47%              | For Cancellation   |   | within CADC 123 of Tadyawan-Mangyan                          | Formerly Sitio Dalayan, Manguyang Gloria, Or. Mdo. |
| Roxas  | Lope Dawis/CSC No. 028574                  | 1.92        | Sitio Dalayan, Barangay Conrazon, Bansud, Oriental Mindoro | November 25, 1992 | 47%              | For Cancellation   |   | within CADC 123 of Tadyawan-Mangyan                          | Formerly Sitio Dalayan, Manguyang Gloria, Or. Mdo. |
| Roxas  | Ponciano Vera/CSC No. 028564               | 2.24        | Sitio Dalayan, Barangay Conrazon, Bansud, Oriental Mindoro | November 25, 1992 | 49%              | For Cancellation   |   | within CADC 123 of Tadyawan-Mangyan                          | Formerly Sitio Dalayan, Manguyang Gloria, Or. Mdo. |


SUMMARY REPORT ON THE PERFORMANCE EVALUATION OF CERTIFICATE OF STEWARDSHIP CONTRACT (CSC)

| OFFICE | NAME OF CS HOLDERS/NUMBER OF CSC EVALUATED | AREA (has.) | LOCATION   | RESULT OF EVALUATION |  | REMARKS (IF CSC WAS TRANSFERRED, INCLUDE THE NAME TO WHOM IT WAS TRANSFERRED AND HIS/HER RELATIONSHIP TO THE CS HOLDER) | ACTION TAKEN BY THE REGION (RENEW/CANCEL/ FOR RE-EVALUATION)                              |
|--------|--|-------------|--|----------------------|--|---|---|
|        |  |             |  | DATE ISSUED          | RECOMMENDATION (FOR RENEWAL/FOR CANCELLATION/ FOR RE-EVALUATION) |   |   |
| Roxas  | Pablo Magadia/CSC No. 028559               | 2.14        | Sitio Dalayan, Barangay Conrazon, Bansud, Oriental Mindoro | November 25, 1992    | 47%  | For Cancellation  | within CADC 123 of Tadyawan-Mangyan<br>Formerly Sitio Dalayan, Manguyana Gloria, Or. Mdo. |


REVIEWED BY:

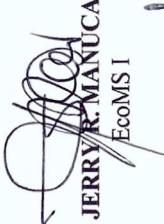  
EcoMS I

NOTED BY:

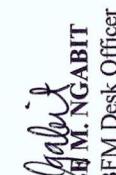  
Forester I/CBFM Desk Officer

ATTESTED BY:

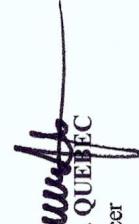  
JOSE T. MONTECALVO  
SEMS/Chief CDS

  
IRENEO HAMIL ET J. EUSTAQUIO II  
Forest Technician II/Member

  
MARCELINA E. NAAMO  
Forest Technician I/Member

  
LARRY D. HERILLA  
Forest Technician I/Member

  
AGNES C. GLORIA  
Forest Technician I/Member

  
JOSE T. MONTECALVO  
SEMS/Chief CDS

  
CAESAR E. QUEBEC  
CENR Officer



  
March 15, 2023  
Date





Republic of the Philippines  
Department of Environment and Natural Resources  
MIMAROPA Region  
**Community Environment and Natural Resources Office**  
Camia St., San Mariano, Roxas, Oriental Mindoro  
Contact No.: 0917 876 9985 / 0917 113 5572  
VOIP: (043) 289-7118  
Email: [cenroroxas\\_orientalmin@yahoo.com](mailto:cenroroxas_orientalmin@yahoo.com)  
[cenroroxas\\_ormindoro@denr.gov.ph](mailto:cenroroxas_ormindoro@denr.gov.ph)

## GEOTAGGED PHOTOS ON PERFORMANCE EVALUATION AND ASSESSMENT OF CSC HOLDERS



### Sitio Dalayan Barangay Manguyang, Gloria, Oriental Mindoro

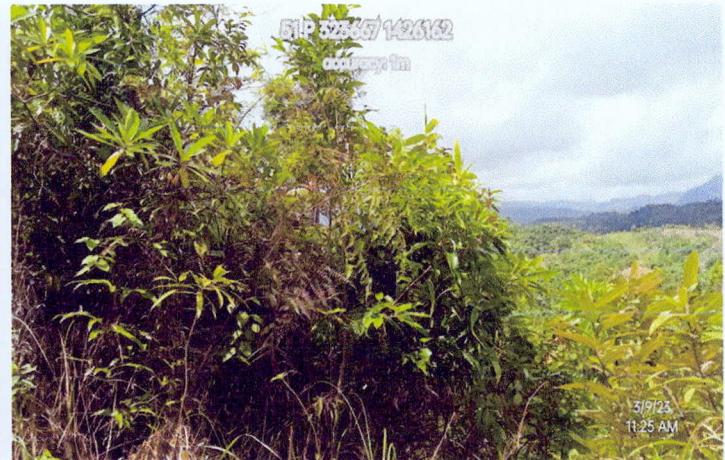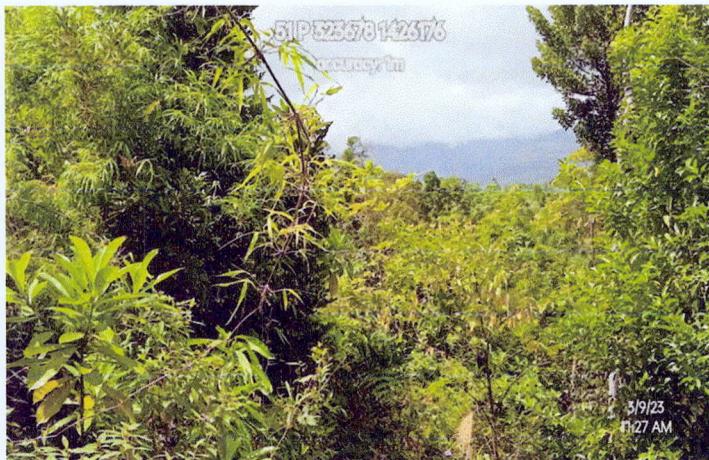

Geotagged Photos showing the Area of Angel Ronkali

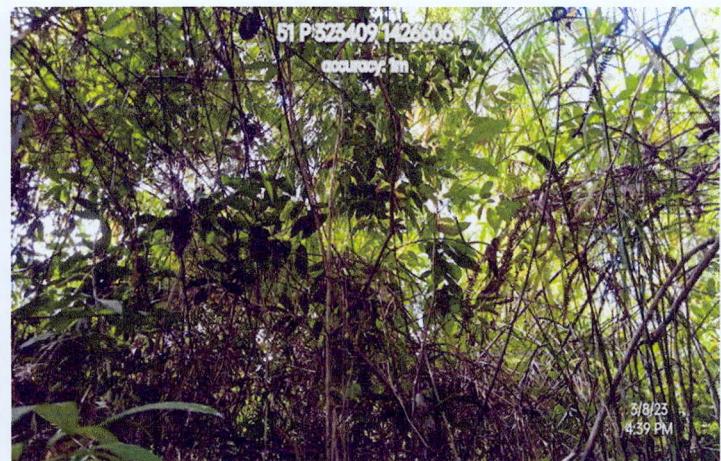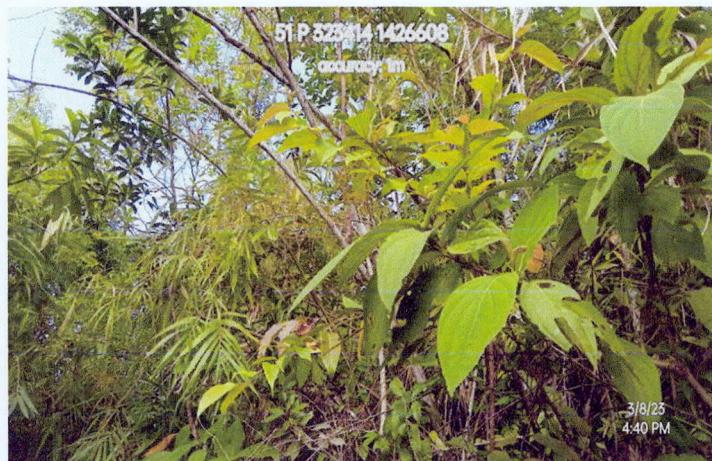

Geotagged Photos showing the Area of Belen Salva

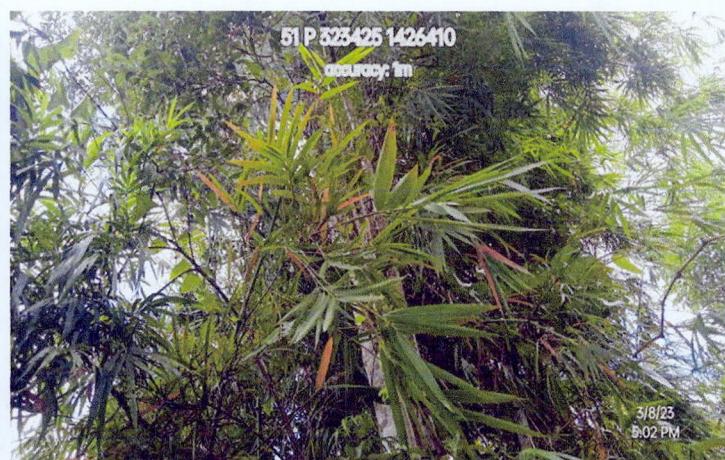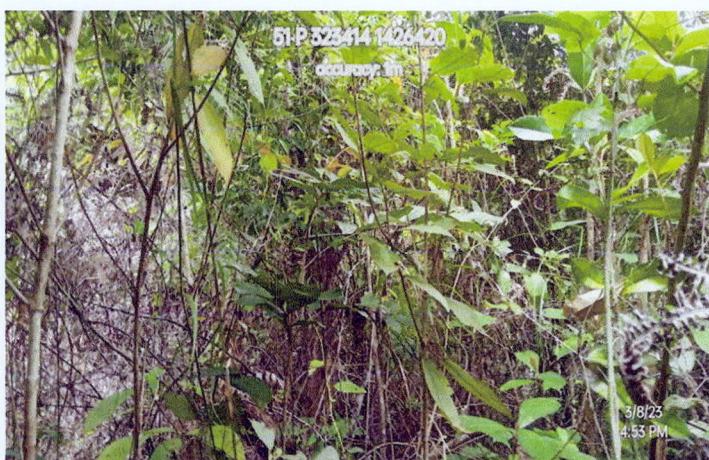

Geotagged Photos showing the Area of Crispin Vera

*[Handwritten signatures]*

*[Handwritten signatures]*



Republic of the Philippines  
Department of Environment and Natural Resources  
MIMAROPA Region  
**Community Environment and Natural Resources Office**  
Camia St., San Mariano, Roxas, Oriental Mindoro  
Contact No.: 0917 876 9985 / 0917 113 5572  
VOIP: (043) 289-7118  
Email: [cenroroxas\\_orientalmin@yahoo.com](mailto:cenroroxas_orientalmin@yahoo.com)  
[cenroroxas\\_ormindoro@denr.gov.ph](mailto:cenroroxas_ormindoro@denr.gov.ph)





Geotagged Photos showing the Area of Dorotea Balmes



Geotagged Photos showing the Area of Estilito Aguado




Geotagged Photos showing the Area of Faustino Saludes

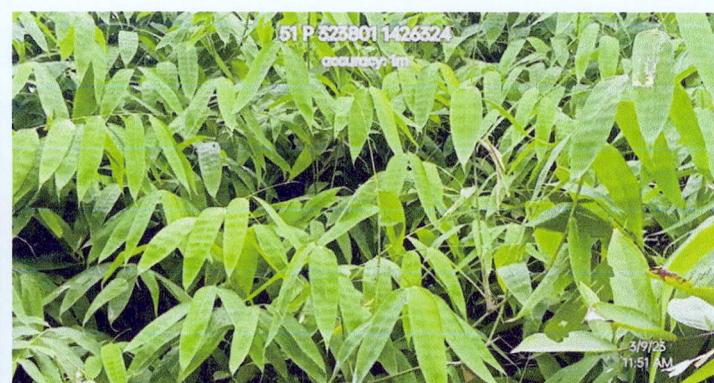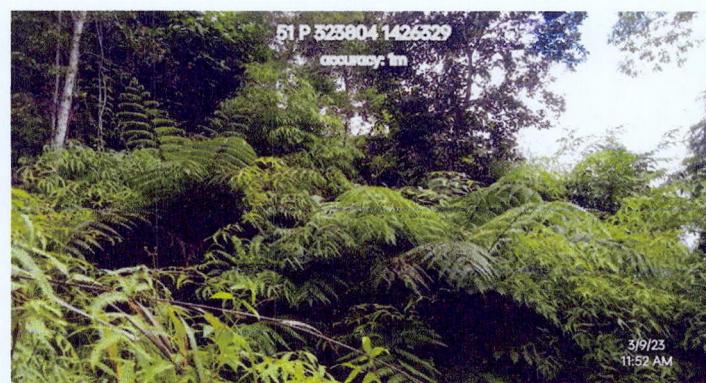


Geotagged Photos showing the Area of Felino Magtibay




Republic of the Philippines  
Department of Environment and Natural Resources  
MIMAROPA Region  
**Community Environment and Natural Resources Office**  
Camia St., San Mariano, Roxas, Oriental Mindoro  
Contact No.: 0917 876 9985 / 0917 113 5572  
VOIP: (043) 289-7118  
Email: [cenroroxas\\_orientalmin@yahoo.com](mailto:cenroroxas_orientalmin@yahoo.com)  
[cenroroxas\\_ormindoro@denr.gov.ph](mailto:cenroroxas_ormindoro@denr.gov.ph)

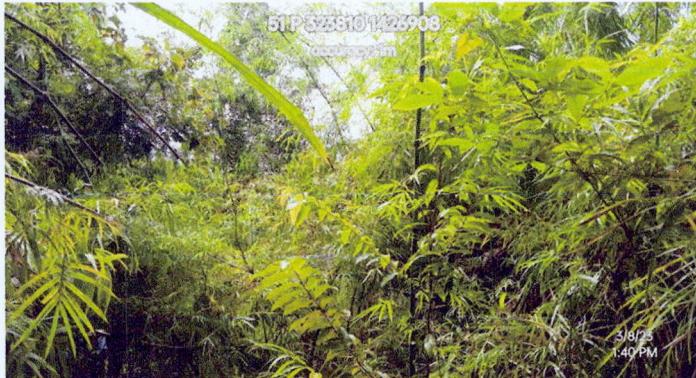



Geotagged Photos showing the Area of Gumersindo Lipat

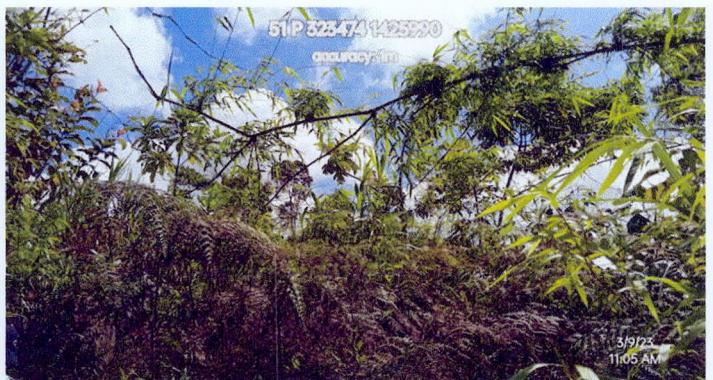

Geotagged Photos showing the Area of Jesus Roncali

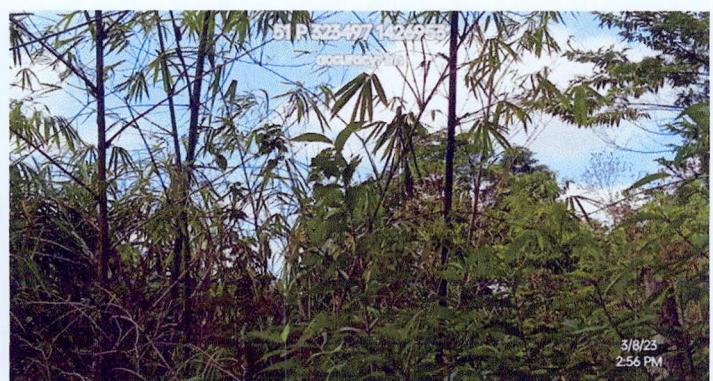

Geotagged Photos showing the Area of Jorge Coz

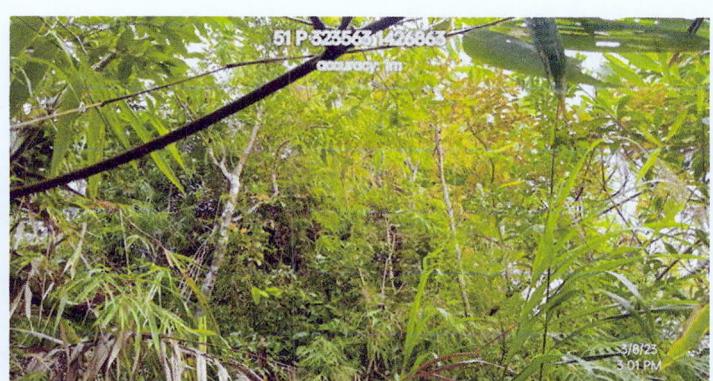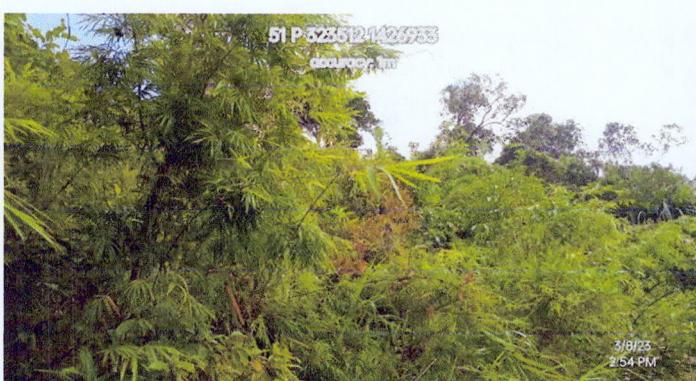

Geotagged Photos showing the Area of Jose Salva

JH

JM dk

CDS/cbfm//mem


S JH AS SS



Republic of the Philippines  
Department of Environment and Natural Resources  
MIMAROPA Region  
**Community Environment and Natural Resources Office**  
Camia St., San Mariano, Roxas, Oriental Mindoro  
Contact No.: 0917 876 9985 / 0917 113 5572  
VOIP: (043) 289-7118  
Email: [cenroroxas\\_orientalmin@yahoo.com](mailto:cenroroxas_orientalmin@yahoo.com)  
[cenroroxas\\_ormindoro@denr.gov.ph](mailto:cenroroxas_ormindoro@denr.gov.ph)




Geotagged Photos showing the Area of Juan Ravanes

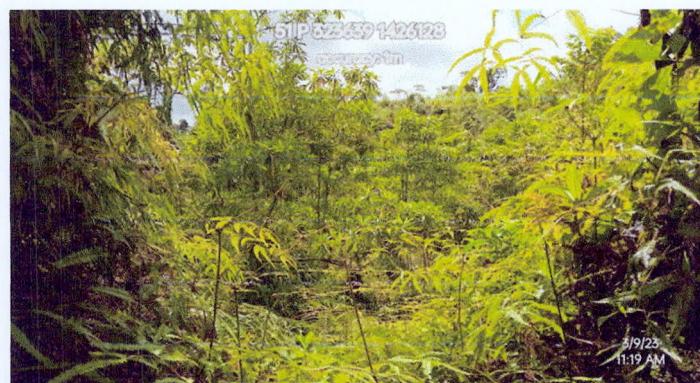

Geotagged Photos showing the Area of Leon Magtibay





Geotagged Photos showing the Area of Manuel Rances

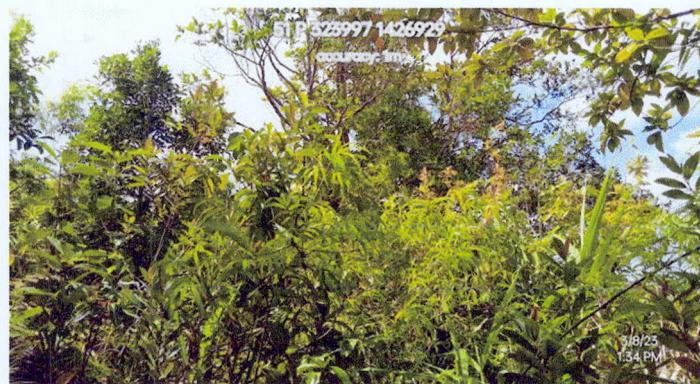


Geotagged Photos showing the Area of Mario Gonzales





Republic of the Philippines  
Department of Environment and Natural Resources  
MIMAROPA Region  
**Community Environment and Natural Resources Office**  
Camia St., San Mariano, Roxas, Oriental Mindoro  
Contact No.: 0917 876 9985 / 0917 113 5572  
VOIP: (043) 289-7118  
Email: [cenroroxas\\_orientalmin@yahoo.com](mailto:cenroroxas_orientalmin@yahoo.com)  
[cenroroxas\\_ormindoro@denr.gov.ph](mailto:cenroroxas_ormindoro@denr.gov.ph)

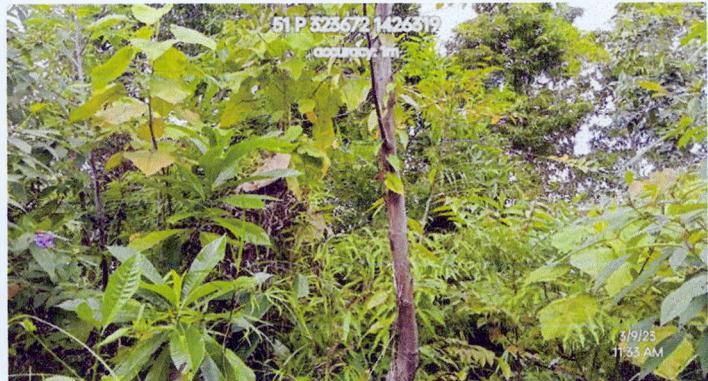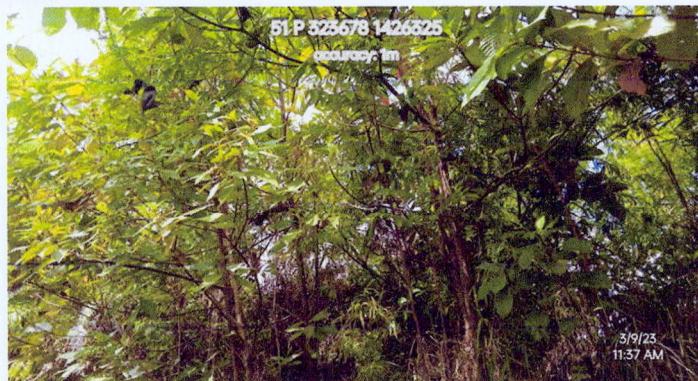



Geotagged Photos showing the Area of Maximo Alcoy

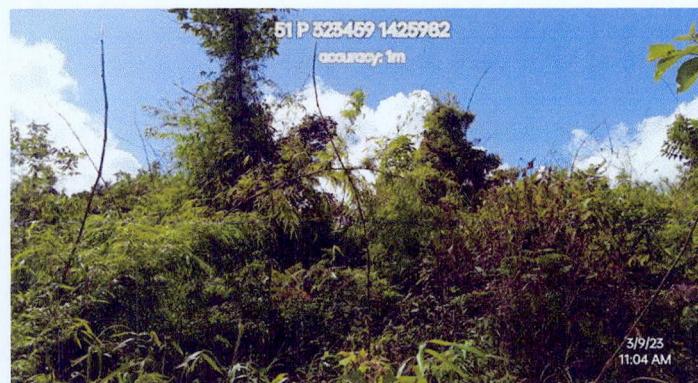

Geotagged Photos showing the Area of Melencio Magsino

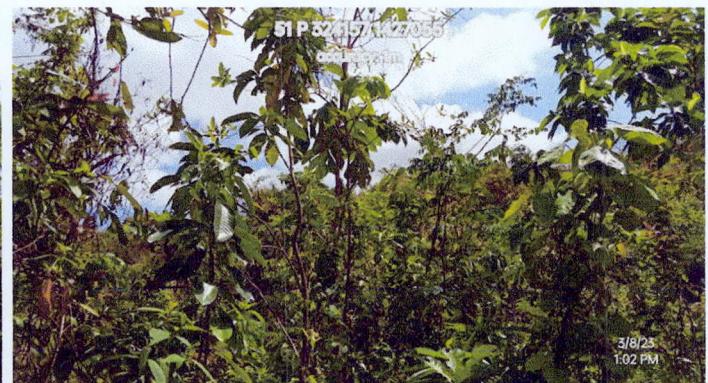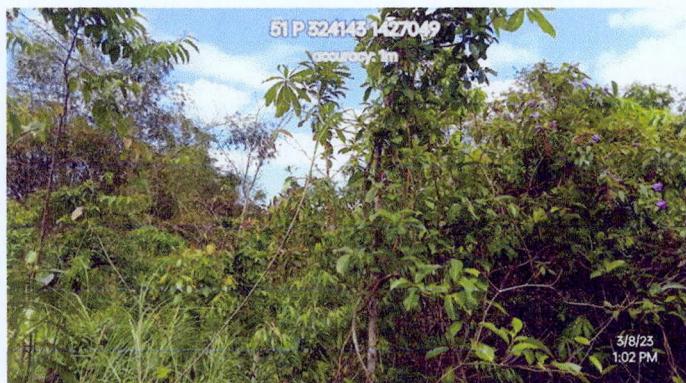

Geotagged Photos showing the Area of Natalio Palma

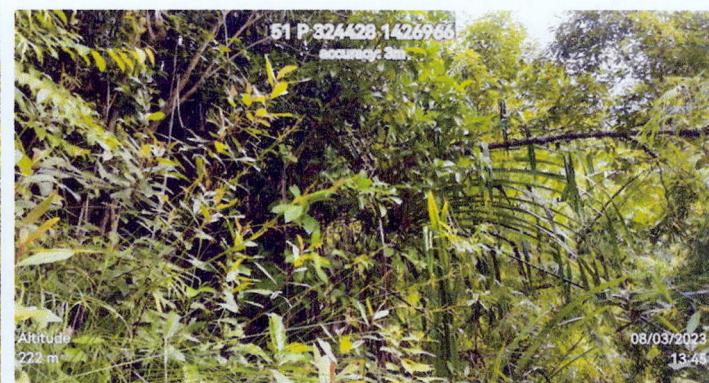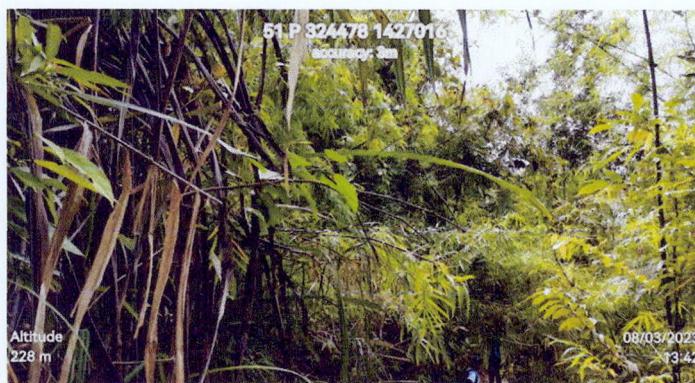

Geotagged Photos showing the Area of Porferio Palma




Republic of the Philippines  
Department of Environment and Natural Resources  
MIMAROPA Region  
**Community Environment and Natural Resources Office**  
Camia St., San Mariano, Roxas, Oriental Mindoro  
Contact No.: 0917 876 9985 / 0917 113 5572  
VOIP: (043) 289-7118  
Email: [cenroroxas\\_orientalmin@yahoo.com](mailto:cenroroxas_orientalmin@yahoo.com)  
[cenroroxas\\_ormindoro@denr.gov.ph](mailto:cenroroxas_ormindoro@denr.gov.ph)





Geotagged Photos showing the Area of Robert Evora



Geotagged Photos showing the Area of Rustico Manalo

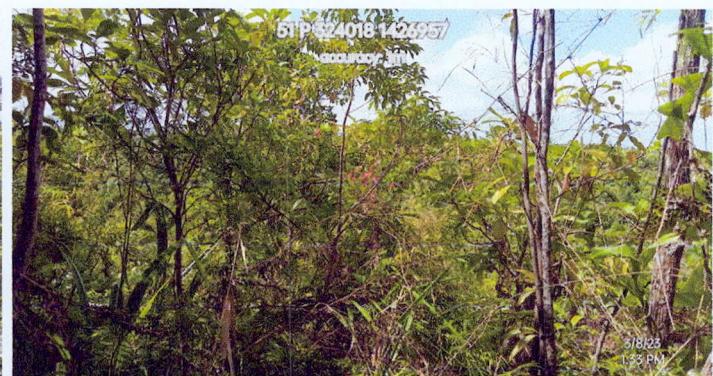

Geotagged Photos showing the Area of Segundo Palma

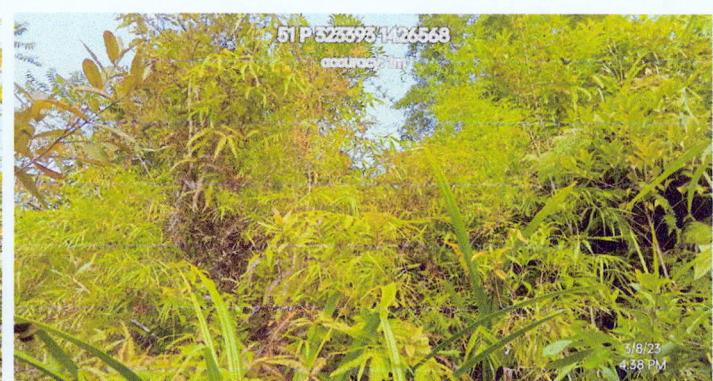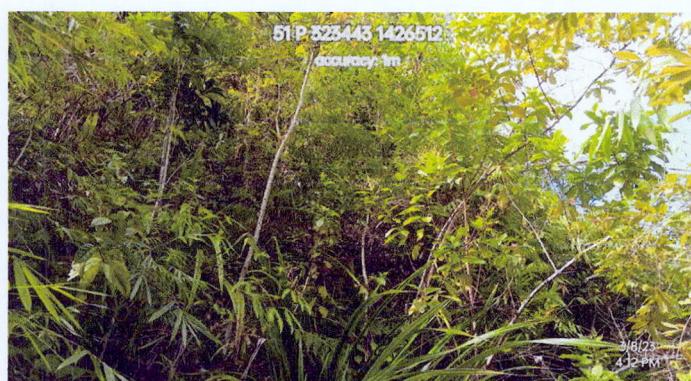


Geotagged Photos showing the Area of Vicente Balmes

*H*  
*Hn*  
*of*

*S*  
*D*  
*SS*



Republic of the Philippines  
Department of Environment and Natural Resources  
MIMAROPA Region  
**Community Environment and Natural Resources Office**  
Camia St., San Mariano, Roxas, Oriental Mindoro  
Contact No.: 0917 876 9985 / 0917 113 5572  
VOIP: (043) 289-7118  
Email: [cenroroxas\\_orientalmin@yahoo.com](mailto:cenroroxas_orientalmin@yahoo.com)  
[cenroroxas\\_ormindoro@denr.gov.ph](mailto:cenroroxas_ormindoro@denr.gov.ph)

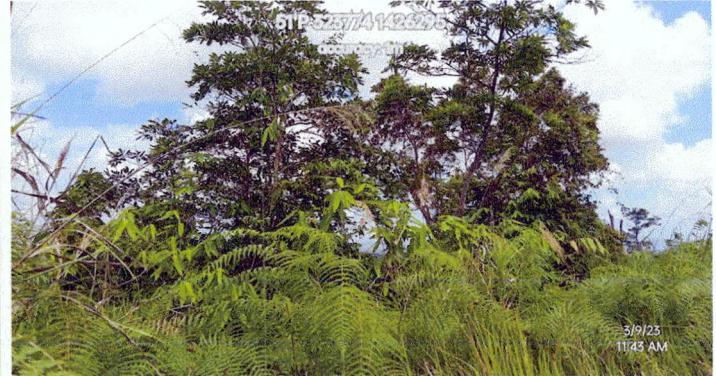



Geotagged Photos showing the Area of Vivcente Roncali




Republic of the Philippines  
Department of Environment and Natural Resources  
MIMAROPA Region  
**Community Environment and Natural Resources Office**  
Camia St., San Mariano, Roxas, Oriental Mindoro  
Contact No.: 0917 876 9985 / 0917 113 5572  
VOIP: (043) 289-7118  
Email: [cenoroxas\\_orientalmin@yahoo.com](mailto:cenoroxas_orientalmin@yahoo.com)  
[cenoroxas\\_ormindoro@denr.gov.ph](mailto:cenoroxas_ormindoro@denr.gov.ph)

## GEOTAGGED PHOTOS ON PERFORMANCE EVALUATION AND ASSESSMENT OF CSC HOLDERS


### Sitio Dalayan, Barangay Conazon, Bansud, Oriental Mindoro

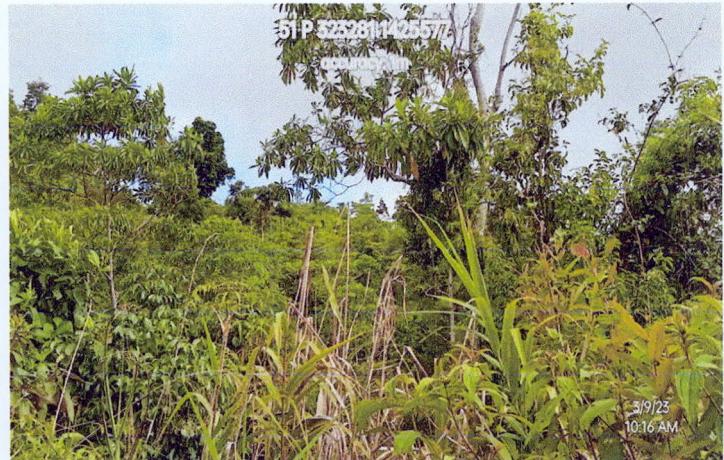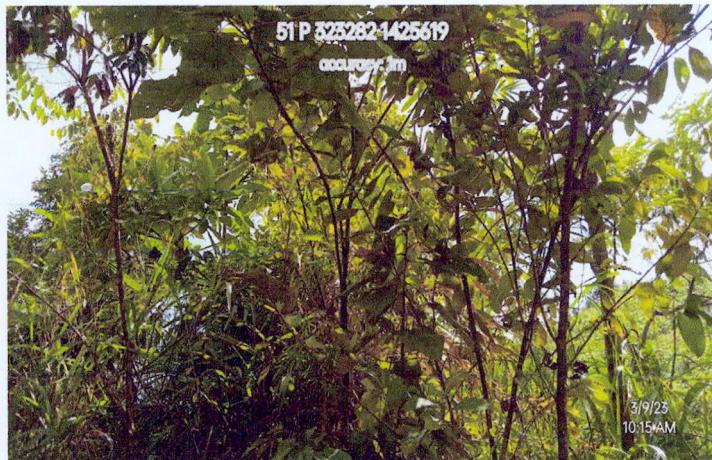

Geotagged Photos showing the Area of Aurora Palma

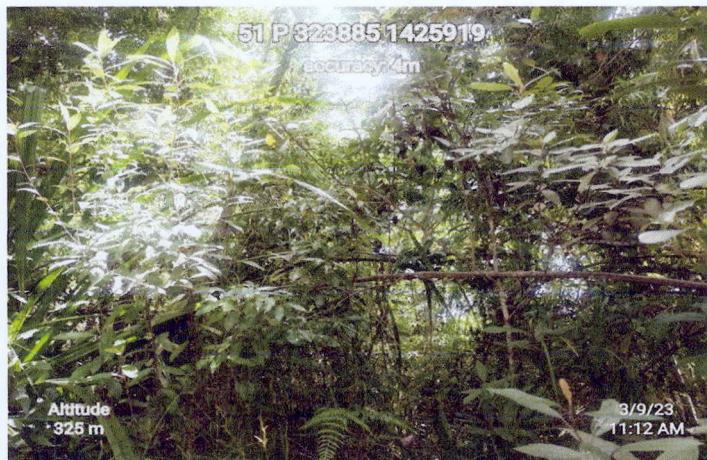


Geotagged Photos showing the Area of Ben Castillo

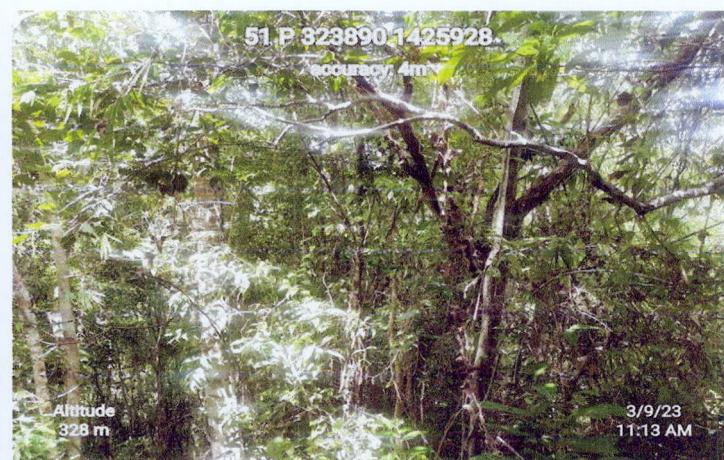


Geotagged Photos showing the Area of Delfin Magadia




Republic of the Philippines  
Department of Environment and Natural Resources  
MIMAROPA Region  
**Community Environment and Natural Resources Office**  
Camia St., San Mariano, Roxas, Oriental Mindoro  
Contact No.: 0917 876 9985 / 0917 113 5572  
VOIP: (043) 289-7118  
Email: [cenroroxas\\_orientalmin@yahoo.com](mailto:cenroroxas_orientalmin@yahoo.com)  
[cenroroxas\\_ormindoro@denr.gov.ph](mailto:cenroroxas_ormindoro@denr.gov.ph)

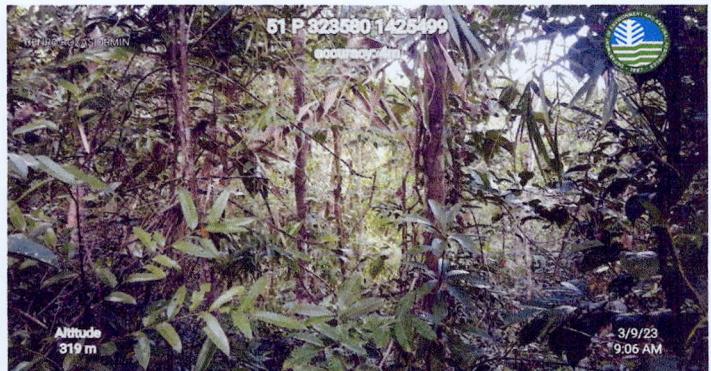


Geotagged Photos showing the Area of Estanislao Ravano

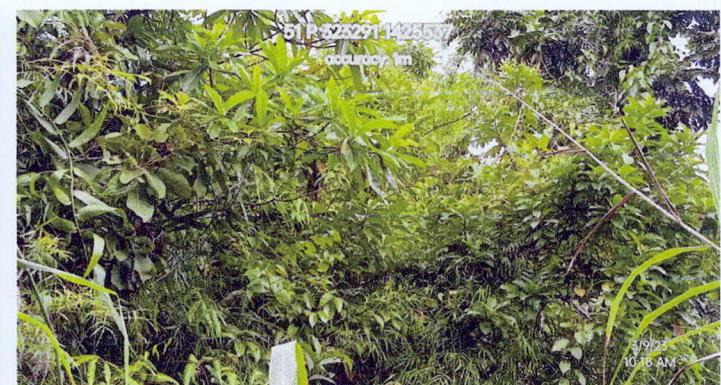

Geotagged Photos showing the Area of Fidela Dawis

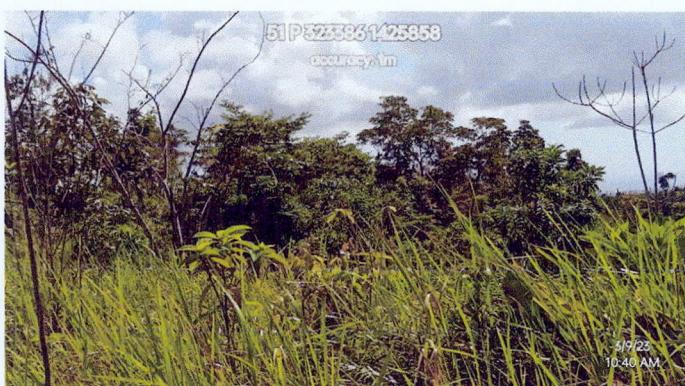


Geotagged Photos showing the Area of Florentino Magsino

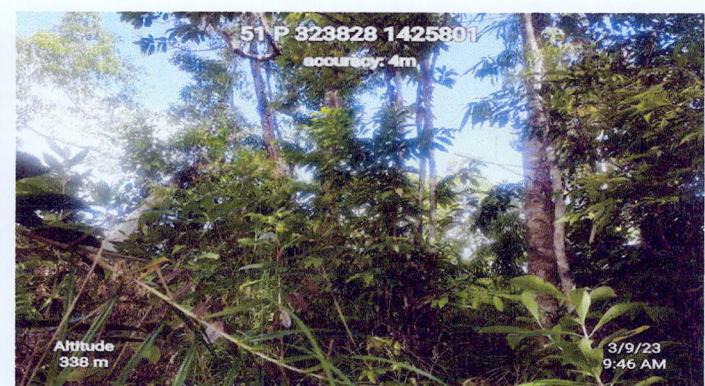

Geotagged Photos showing the Area of Jose Castillo





Republic of the Philippines  
Department of Environment and Natural Resources  
MIMAROPA Region  
**Community Environment and Natural Resources Office**  
Camia St., San Mariano, Roxas, Oriental Mindoro  
Contact No.: 0917 876 9985 / 0917 113 5572  
VOIP: (043) 289-7118  
Email: [cenroroxas\\_orientalmin@yahoo.com](mailto:cenroroxas_orientalmin@yahoo.com)  
[cenroroxas\\_ormindoro@denr.gov.ph](mailto:cenroroxas_ormindoro@denr.gov.ph)

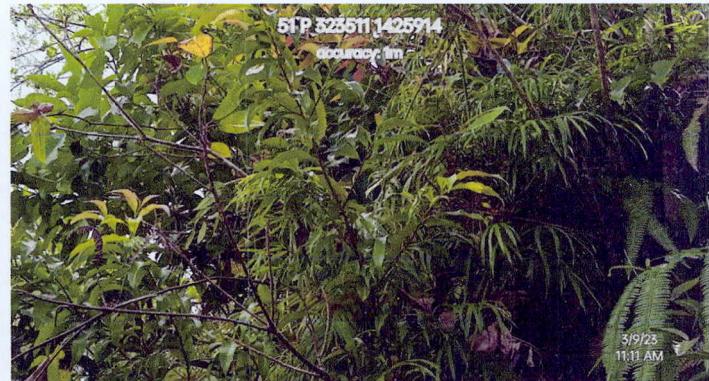


Geotagged Photos showing the Area of Jose Ilao



Geotagged Photos showing the Area of Jovito Ravano

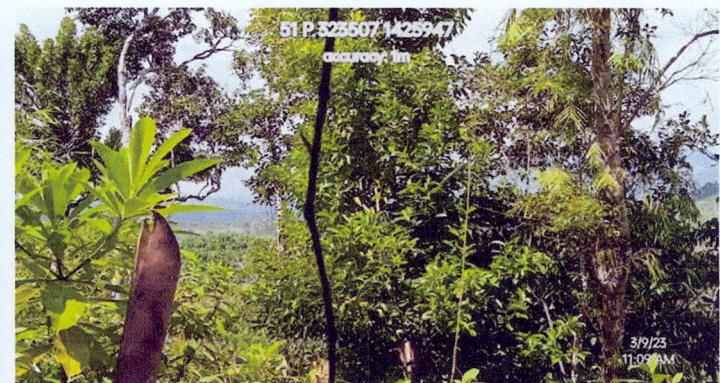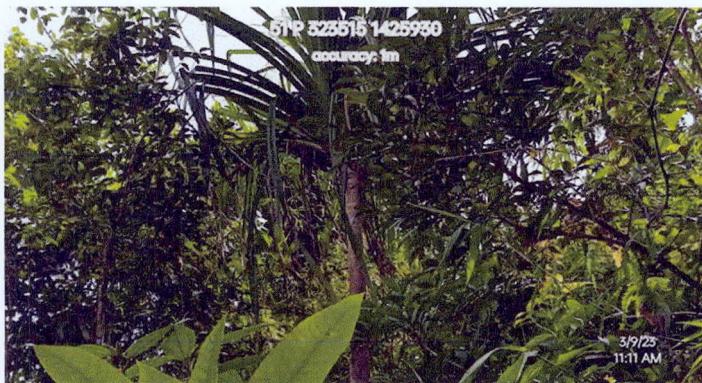

Geotagged Photos showing the Area of Julian Ilao

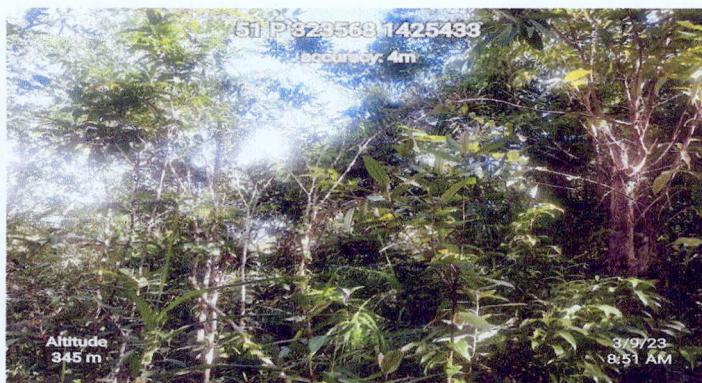



Geotagged Photos showing the Area of Lope Dawis

*dt* *9t* *fm*

*JK* *9t* *OR*



Republic of the Philippines  
Department of Environment and Natural Resources  
MIMAROPA Region  
**Community Environment and Natural Resources Office**  
Camia St., San Mariano, Roxas, Oriental Mindoro  
Contact No.: 0917 876 9985 / 0917 113 5572  
VOIP: (043) 289-7118  
Email: [cenoroxas\\_orientalmin@yahoo.com](mailto:cenoroxas_orientalmin@yahoo.com)  
[cenoroxas\\_ormindoro@denr.gov.ph](mailto:cenoroxas_ormindoro@denr.gov.ph)

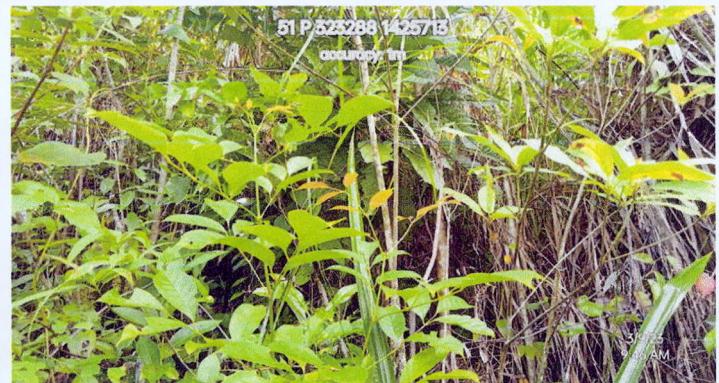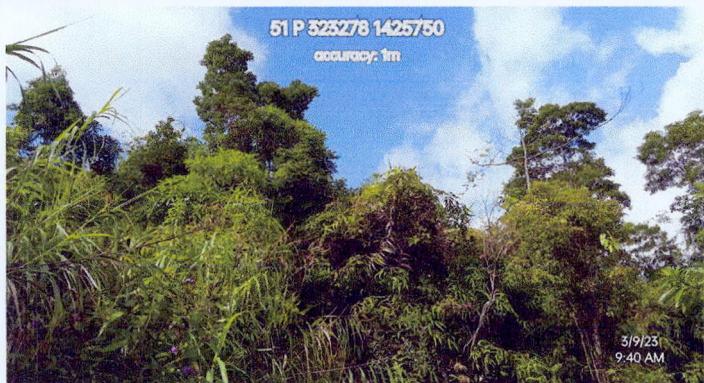

Geotagged Photos showing the Area of Nelson Palma



Geotagged Photos showing the Area of Pablo Magadia




Geotagged Photos showing the Area of Pedro Mazo




Geotagged Photos showing the Area of Pelagio Magsino



Republic of the Philippines  
Department of Environment and Natural Resources  
MIMAROPA Region  
**Community Environment and Natural Resources Office**  
Camia St., San Mariano, Roxas, Oriental Mindoro  
Contact No.: 0917 876 9985 / 0917 113 5572  
VOIP: (043) 289-7118  
Email: [cenroroxas\\_orientalmin@yahoo.com](mailto:cenroroxas_orientalmin@yahoo.com)  
[cenroroxas\\_ormindoro@denr.gov.ph](mailto:cenroroxas_ormindoro@denr.gov.ph)

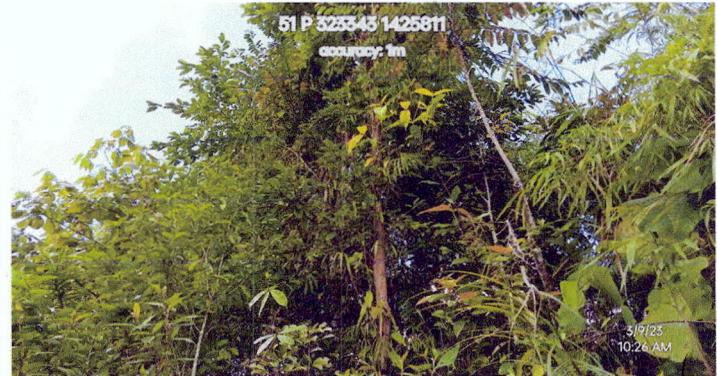

Geotagged Photos showing the Area of Ponciano Vera

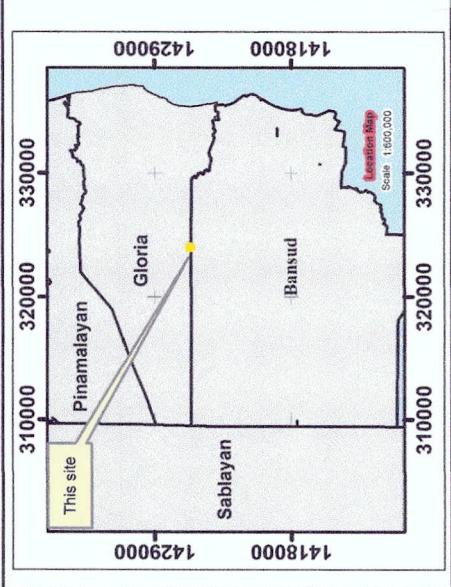

**CERTIFICATE OF STEWARDSHIP CONTRACT  
(CSC) NO. 028558**

**OF**

**MANUEL RANCES**

LOCATION: Barangay : Manguyang  
Municipality : Gloria  
Province : Oriental Mindoro

Total Area : 3.2100 Hectares

Scale 1:3,000

Spheroid..... Clarke 1886  
Projection..... Universal Transverse Mercator (Zone 51)  
Horizontal Datum..... WGS 1984

**LEGEND**



- CSC Corner
- CSC Area
- CADC 123 Boundary
- Rivers and creeks
- Municipal Boundary


**CERTIFICATION**  
This is to certify that this is the true and correct map of the areas under CERTIFICATE OF STEWARDSHIP CONTRACT (CSC) No. 028558 of Manuel Rances as described herein.  
This map was prepared based on the submitted maps, documents and other references available from this office.

**MINDORO PROJ. NO. 4 - H BLOCK - C  
APPROVED JANUARY 04, 1960, L.C. MAP NO. 2319**

Prepared by:  
  
MANUEL M. NGABIT  
Forest CSFM Desk Officer  
Approved by:  
  
CESAREO QUEBEC  
CENR Officer

Date: March 13, 2023  
Date: March 15, 2023  
Copyright 2023

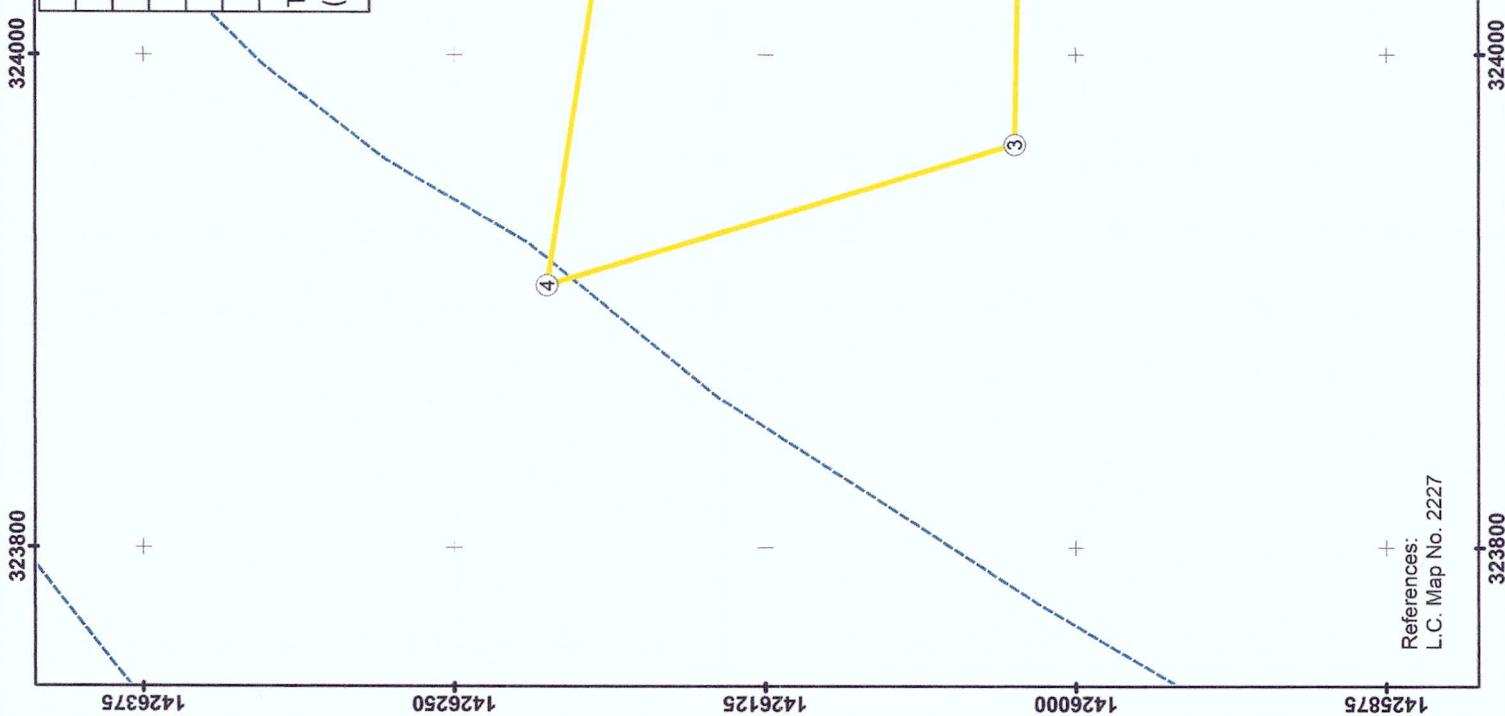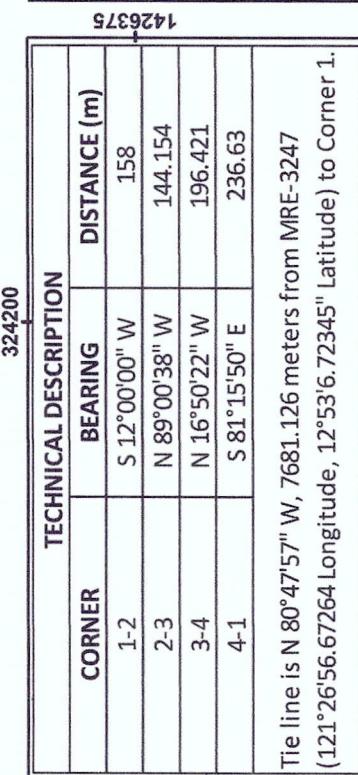

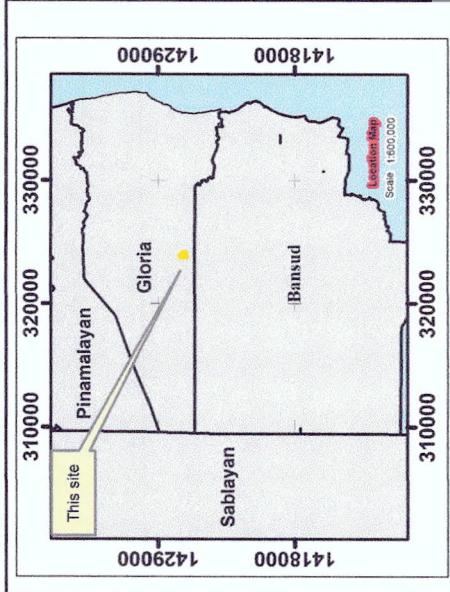

**CERTIFICATE OF STEWARDSHIP CONTRACT  
(CSC) NO. 028540  
OF**

**MARIO GONZALES**

**LOCATION:** Barangay : Manguyang  
Municipality : Gloria  
Province : Oriental Mindoro

Total Area : 2.5200 Hectares

Scale 1:3,000  
0 2,435 5,250 10,000 15,759 21,600  
Metres  
Spheroid.....Clarke 1886  
Projection.....Universal Transverse Mercator (Zone 51)  
Horizontal Datum.....WGS 1984

**LEGEND**

- CSC Corner
- CSC Area
- Municipal Boundary



NOTE: The political boundaries are not authoritative.

This is to certify that this is the true and correct map of the areas under  
CERTIFICATE OF STEWARDSHIP CONTRACT (CSC) No. 028540 of  
Mario Gonzales as described hereon.  
This map was prepared based on the submitted maps, documents and  
other references available from this office.

**MINDORO PROJ NO. 4 - H BLOCK - C  
APPROVED JANUARY 04, 1960, L.C. MAP NO. 2319**

References:  
L.C. Map No. 2227  
Copyright 2023

Prepared by: *Mario Gonzales* MARIO GONZALES  
Forester/FCBM Desk Officer  
March 13, 2023 Date


Approved by: *Engr. Jose S. Quebec* ENGR. JOSE S. QUEBEC  
CEAR Officer  
March 15, 2023 Date

324075  
323900  
323725

Copyright 2023


| TECHNICAL DESCRIPTION |               |              |
|-----------------------|---------------|--------------|
| CORNER                | BEARING       | DISTANCE (m) |
| 1-2                   | S 76°01'14" W | 198.591      |
| 2-3                   | N 00°00'00" W | 262          |
| 3-1                   | S 42°00'00" E | 288          |

Tie line is N 75°45'53" W, 7899.534 meters from MRE-3247  
(121°26'56.67264 Longitude, 12°53'6.72345" Latitude, to Corner 1.

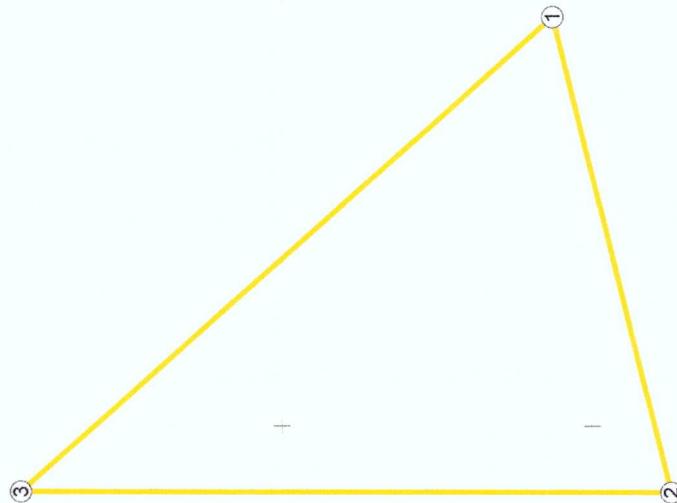

1426750  
1426875  
1427000  
1427125  
1427250

323725  
323900  
324075

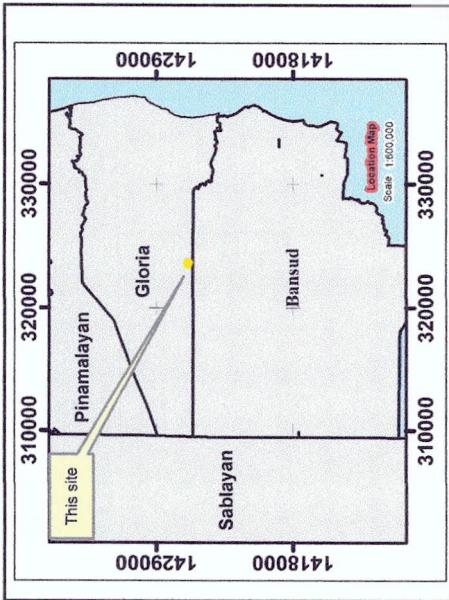

**CERTIFICATE OF STEWARDSHIP CONTRACT  
(CSC) NO. 028551  
OF**

**MAXIMO ALCOY**

**LOCATION:**  
Barangay : Manguyang  
Municipality : Gloria  
Province : Oriental Mindoro


**Total Area : 3.4500 Hectares**

Scale 1:3,000  
0 2,435 3,750 10,800 15,750 21,600  
Meters  
Projection.....Universal Transverse Mercator (Zone 51)  
Spheroid.....Clarke 1886  
Horizontal Datum.....WGS 1984

**LEGEND**

- CSC Corner
- CSC Area
- Municipal Boundary

NOTE: The political boundaries are not authoritative.

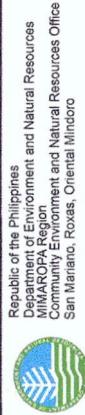

**CERTIFICATION**

This is to certify that this is the true and correct map of the areas under CERTIFICATE OF STEWARDSHIP CONTRACT (CSC) No. 028551 of Maximo Alcoy as described herein.

This map was prepared based on the submitted maps, documents and other references available from this office.

Prepared by:

**MARIELLE M. NGABIT**  
Forester, CSC/BFM Desk Officer

March 13, 2023

Approved by:


**ENGR. CESAR E. QUEBEC**  
CENR Officer


March 15, 2023

Copyright 2023

| TECHNICAL DESCRIPTION |               |              |
|-----------------------|---------------|--------------|
| CORNER                | BEARING       | DISTANCE (m) |
| 1-2                   | S 11°49'37" W | 204.956      |
| 2-3                   | N 62°48'35" W | 248.553      |
| 3-4                   | N 26°00'00" E | 99.996       |
| 4-1                   | S 89°15'22" E | 219.277      |

Tie line is N 78°56'53" W, 8147.124 meters from MRE-3247 (121°26'56.67264 Longitude, 12°53'6.72345" Latitude) to Corner 1.

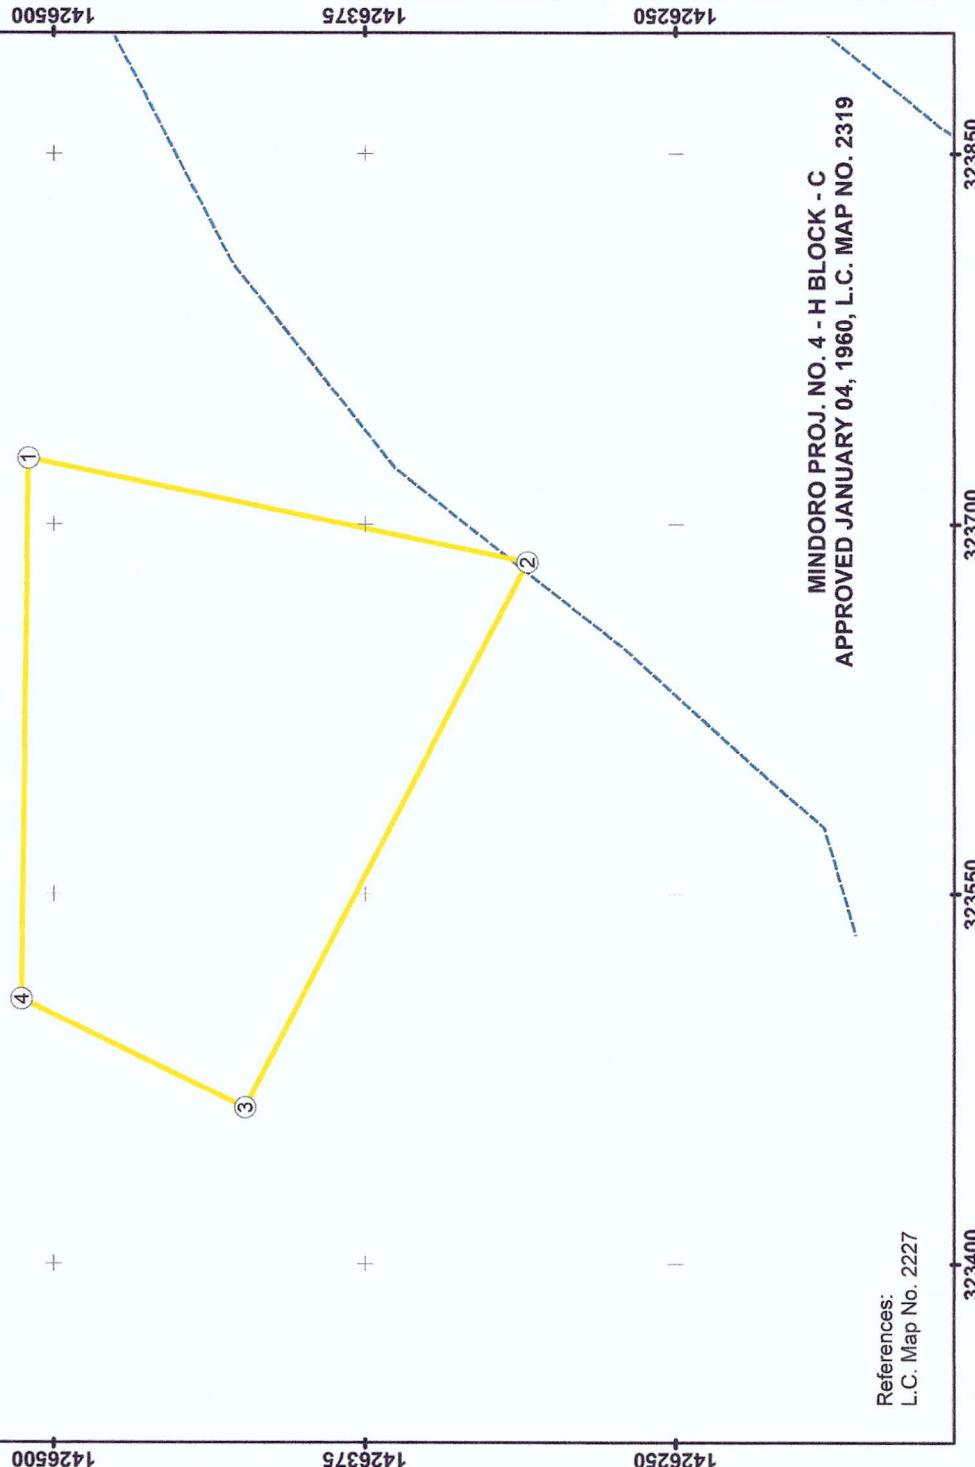

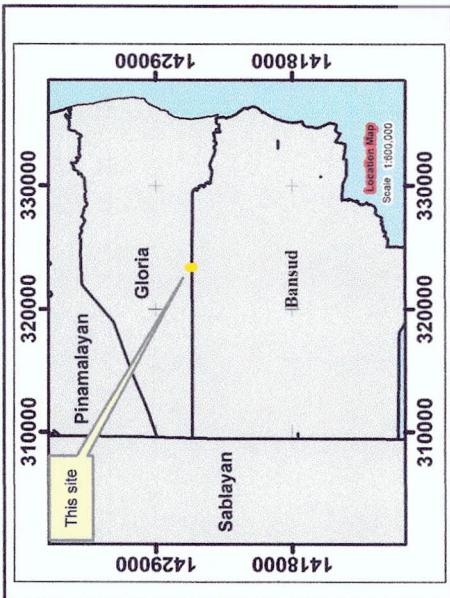

2

**CERTIFICATE OF STEWARDSHIP CONTRACT  
(CSC) NO. 028577**

MENÉNCIO MAGSINO

**LOCATION:** Barangay : Manguyang  
Municipality : Gloria  
Province : Oriental Mindoro

Total Area : 3,5700 Hectares

Scale 1:4,000

Spheroid..... Clarke 1886  
 Projection..... Universal Transverse Mercator (Zone 51)  
 Horizontal Datum..... WGS 1984  
 Meters


## LEGEND


## CERTIFICATION

This is to certify that this is the true and correct map of the areas under CERTIFICATE OF STEWARDSHIP CONTRACT (CSC) No. 028577 of Meliendo Magino as described herein.  
This map was prepared based on the submitted maps, documents and other references available from this office.

MINDORO PROJ. NO. 4 - H BLOCK - C  
APPROVED JANUARY 04, 1960, L.C. MAP NO. 2319  
42580

References:  
L.C. Map No. 2227

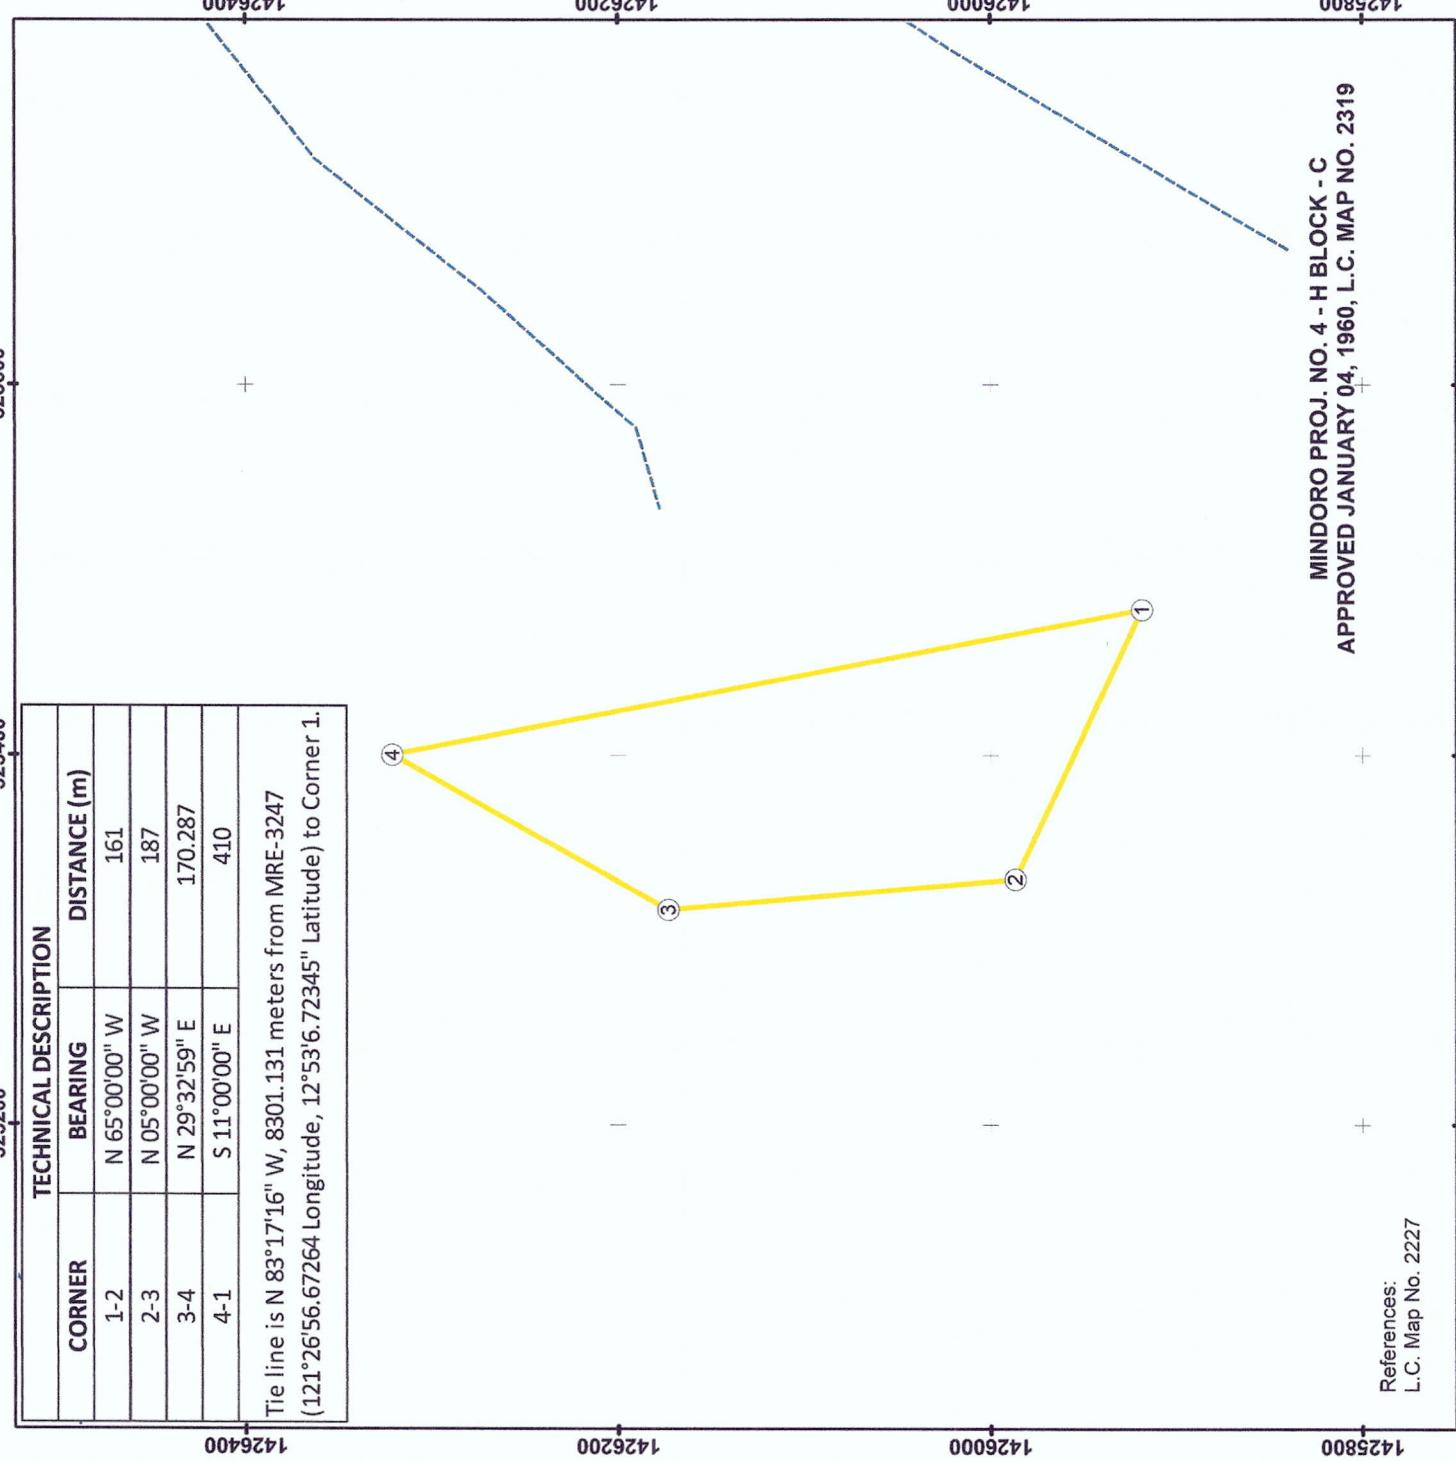

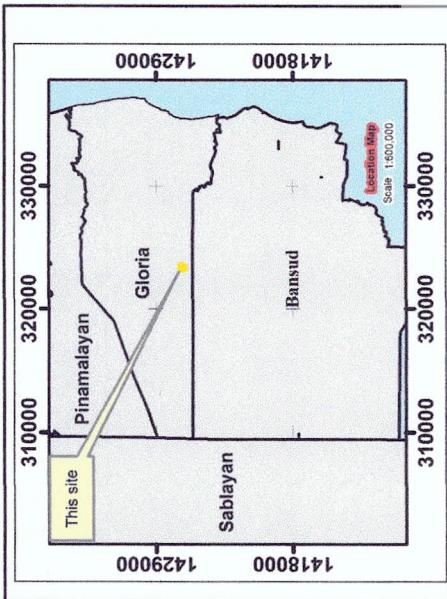

1418000 1429000 1429000 1418000 1418000 1427050

310000 320000 330000 310000 320000 330000

1427050 1426900 1427050

323400 323550 323400 323550

**CERTIFICATE OF STEWARDSHIP CONTRACT**  
(CSC) NO. 028545  
OF

**JORGE COZ**

LOCATION: Barangay : Manguyang  
Municipality : Gloria  
Province : Oriental Mindoro

Total Area : 3.2900 Hectares

Scale 1:3,000

0 2,425 5,820 10,600 15,375 21,1500

Projection: Universal Transverse Mercator Zone 51  
Horizontal Datum: WGS 1984

**LEGEND**

- CSC Corner
- CSC Area
- Rivers and creeks
- Municipal Boundary

NOTE: The political boundaries are not authoritative.

**CERTIFICATE OF STEWARDSHIP CONTRACT** (CSC) No. 028545 of Jorge Coz as described hereon.

This map was prepared based on the submitted maps, documents and other references available from this office.

Prepared by:

**MARIELE M. NGABIT**  
Forester/CBFM Desk Officer

Approved by:

**ENGR. CAESARE QUEBEC**  
CENR Officer


March 13, 2023


March 15, 2023

Date

Date

Copyright 2023

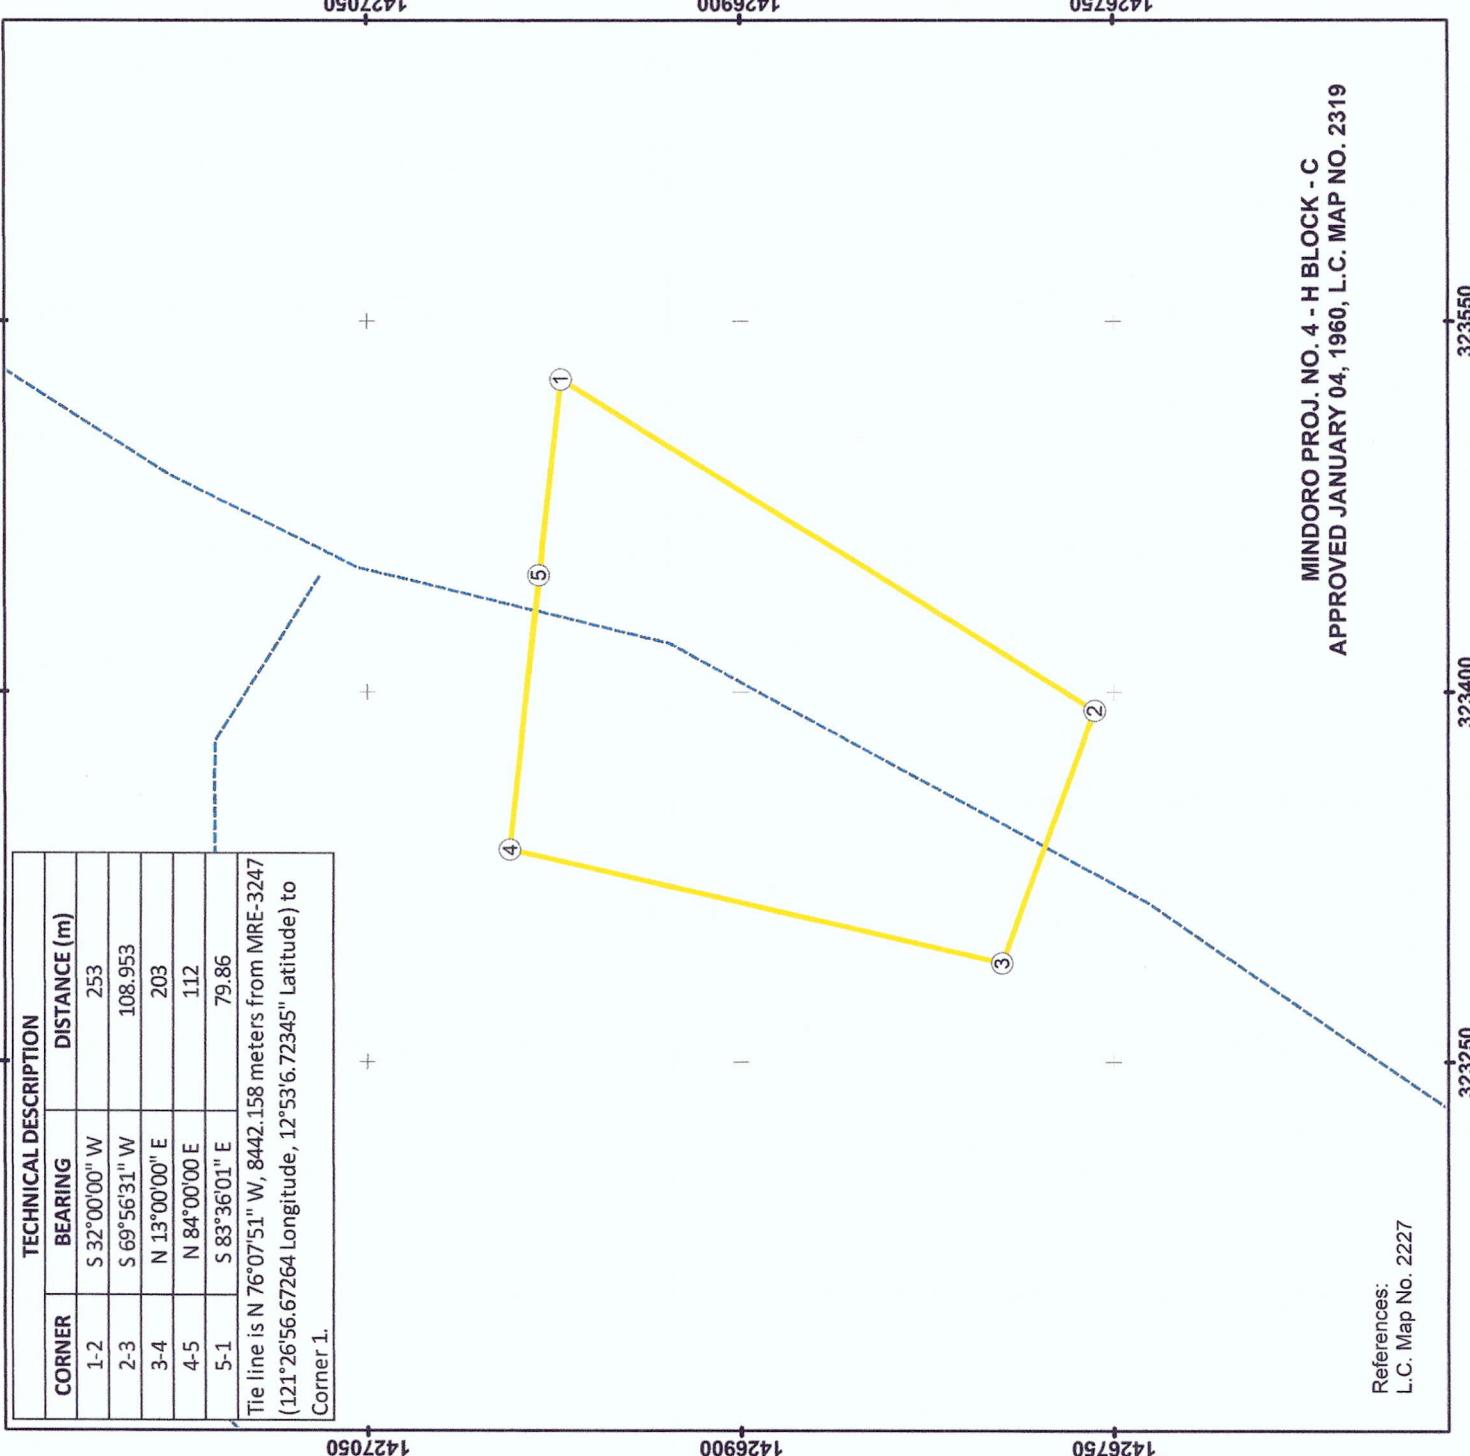

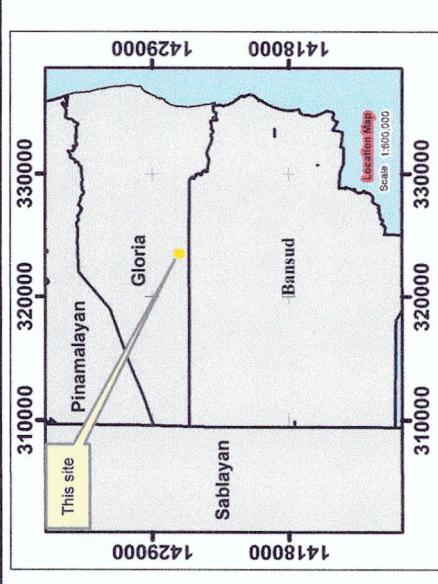

**CERTIFICATE OF STEWARDSHIP CONTRACT  
(CSC) NO. 028543  
OF**

**JOSE SALVA**

LOCATION: Barangay : Manguyang  
Municipality : Gloria  
Province : Oriental Mindoro

Total Area : 2.5200 Hectares

Scale 1:3,000  
0 2.05 3.20 5.20 10.20 15.20 21.00  
Meters  
Spheroid.....Clarke 1866  
Projection.....Universal Transverse Mercator (Zone 51)  
Horizontal Datum.....WGS 1984

**LEGEND**

- CSC Corner
- CSC Area
- Municipal Boundary

**CERTIFICATION**

This is to certify that this is the true and correct map of the areas under CERTIFICATE OF STEWARDSHIP CONTRACT (CSC) No. 028543 of Jose Salva as described hereon.  
This map was prepared based on the submitted maps, documents and other references available from this office.

Approved by:

MARIE L. NGABIT  
Forester MBBM Desk Officer  
March 13, 2023  
Date  
ENGR. GAFAR E. QUEBEB  
CEAHR Officer  
March 15, 2023  
Date

Copyright 2023

**MINDORO PROJ NO. 4 - H BLOCK - C  
APPROVED JANUARY 04, 1960, L.C. MAP NO. 2319**

References:  
L.C. Map No. 2227

323700

323550

323400

323250

323400


323550

323700

323250


| TECHNICAL DESCRIPTION |               |              |
|-----------------------|---------------|--------------|
| CORNER                | BEARING       | DISTANCE (m) |
| 1-2                   | N 72°00'00" W | 150          |
| 2-3                   | N 32°00'00" E | 253          |
| 3-4                   | S 21°00'00" E | 158          |
| 4-1                   | S 22°57'20" W | 123.156      |

Tie line is N 77°51'00" W, 8375.048 meters from MRE-3247  
(121°26'56.67264 Longitude, 12°53'6.72345" Latitude) to Corner 1.

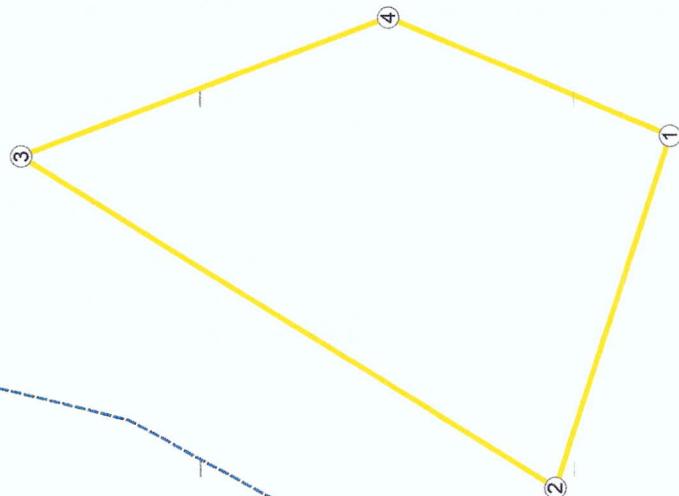

1426900 142750 1426600

Copyright 2023

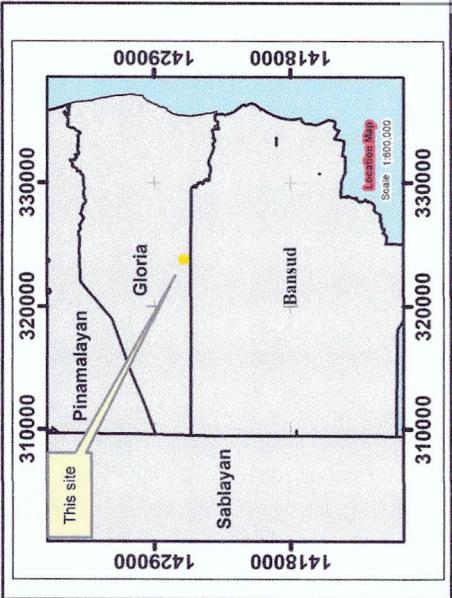

**CERTIFICATE OF STEWARDSHIP CONTRACT  
( CSC ) NO. 028549**

JUAN RAVANES

Barangay : Manguyang  
Municipality : Gloria  
Province : Oriental Mindoro

Total Area : 3,7900 Hectares

Scale 1:3,000

Spheroid..... Clarke 1866  
Projection..... Universal Transverse Mercator (Zone 13)  
Horizontal Datum..... WGS 1984  
Vertical Datum..... Mean Sea Level

## LEGEND

- CSC Corner 
- CSC Area 
- Rivers and creeks 
- Municipal Boundary 





## CERTIFICATION


This is to certify that this is the true and correct map of the areas under CERTIFICATE OF STEWARDSHIP CONTRACT (CSC) No. 028549 of Juan Ravanes as described hereon.  
This map was prepared based on the submitted maps, documents and other information available for review.

Prepared by:  
Approved by:

L.C. Map No. 2227

MINDORO PROJ. NO. 4 - H BLOCK - C  
APPROVED JANUARY 04, 1960, L.C. MAP NO. 2319

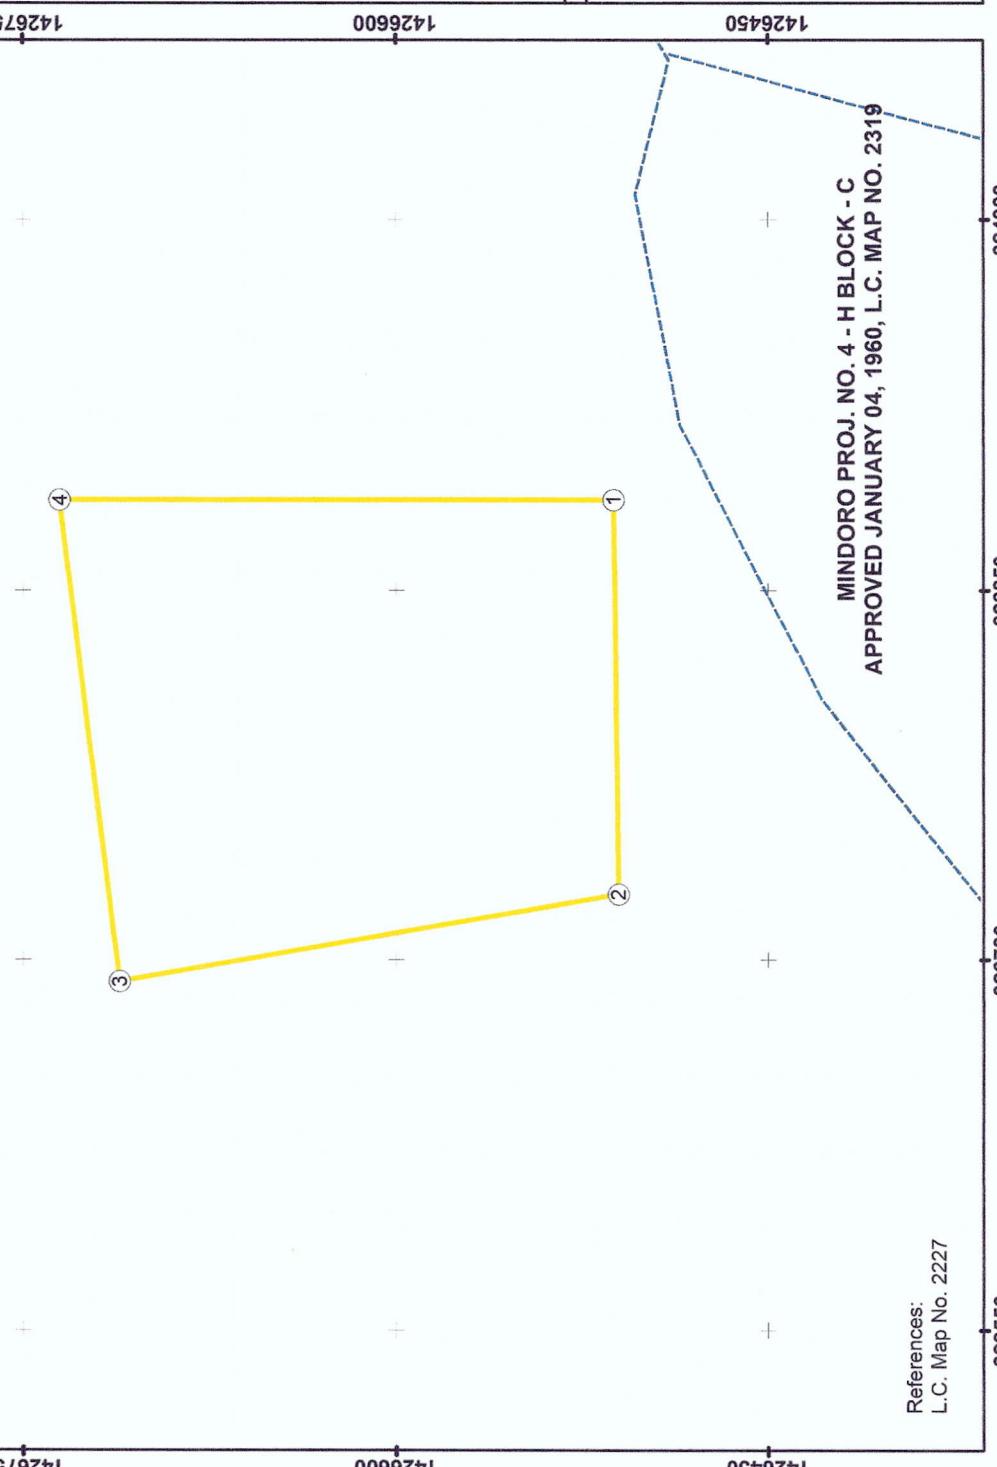

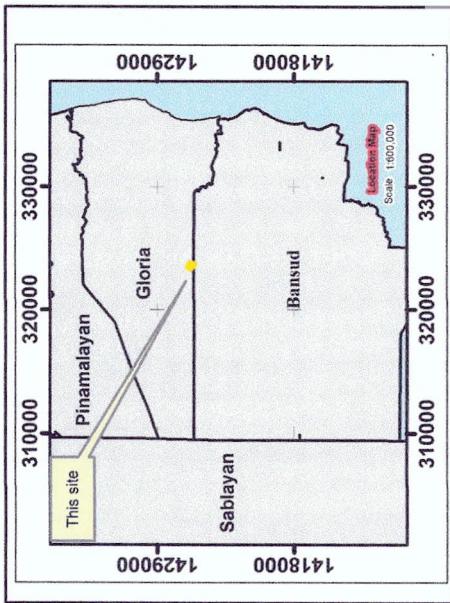

**CERTIFICATE OF STEWARDSHIP CONTRACT  
(CSC) NO. 028554  
OF**

**LEON MAGTIBAY**

**LOCATION:** Barangay : Manguyang  
Municipality : Gloria  
Province : Oriental Mindoro


**Total Area : 4,3900 Hectares**

Scale 1:4,000  
0 2,400 4,800 7,200 9,600 12,000  
Meters  
Spheroid.....Clarke 1886  
Projection.....Universal Transverse Mercator (Zone 51)  
Horizontal Datum.....WGS 1984

**LEGEND**

- CSC Corner
- CSC Area
- Municipal Boundary

NOTE: The political boundaries are not authoritative.

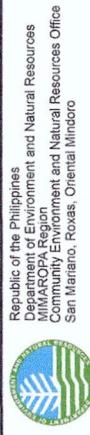

**CERTIFICATION**

This is to certify that this is the true and correct map of the areas under CERTIFICATE OF STEWARDSHIP CONTRACT (CSC) No. 028554 of Leon Magtibay as described herein.  
This map was prepared based on the submitted maps, documents and other references available from this office.

Prepared by:


MARELA S. AGABIT  
Forester/CBFM Desk Officer


March 13, 2023  
Date

ENGR. CESAR E. QUIPPEC  
ENR Officer

March 15, 2023  
Date

Copyright 2023

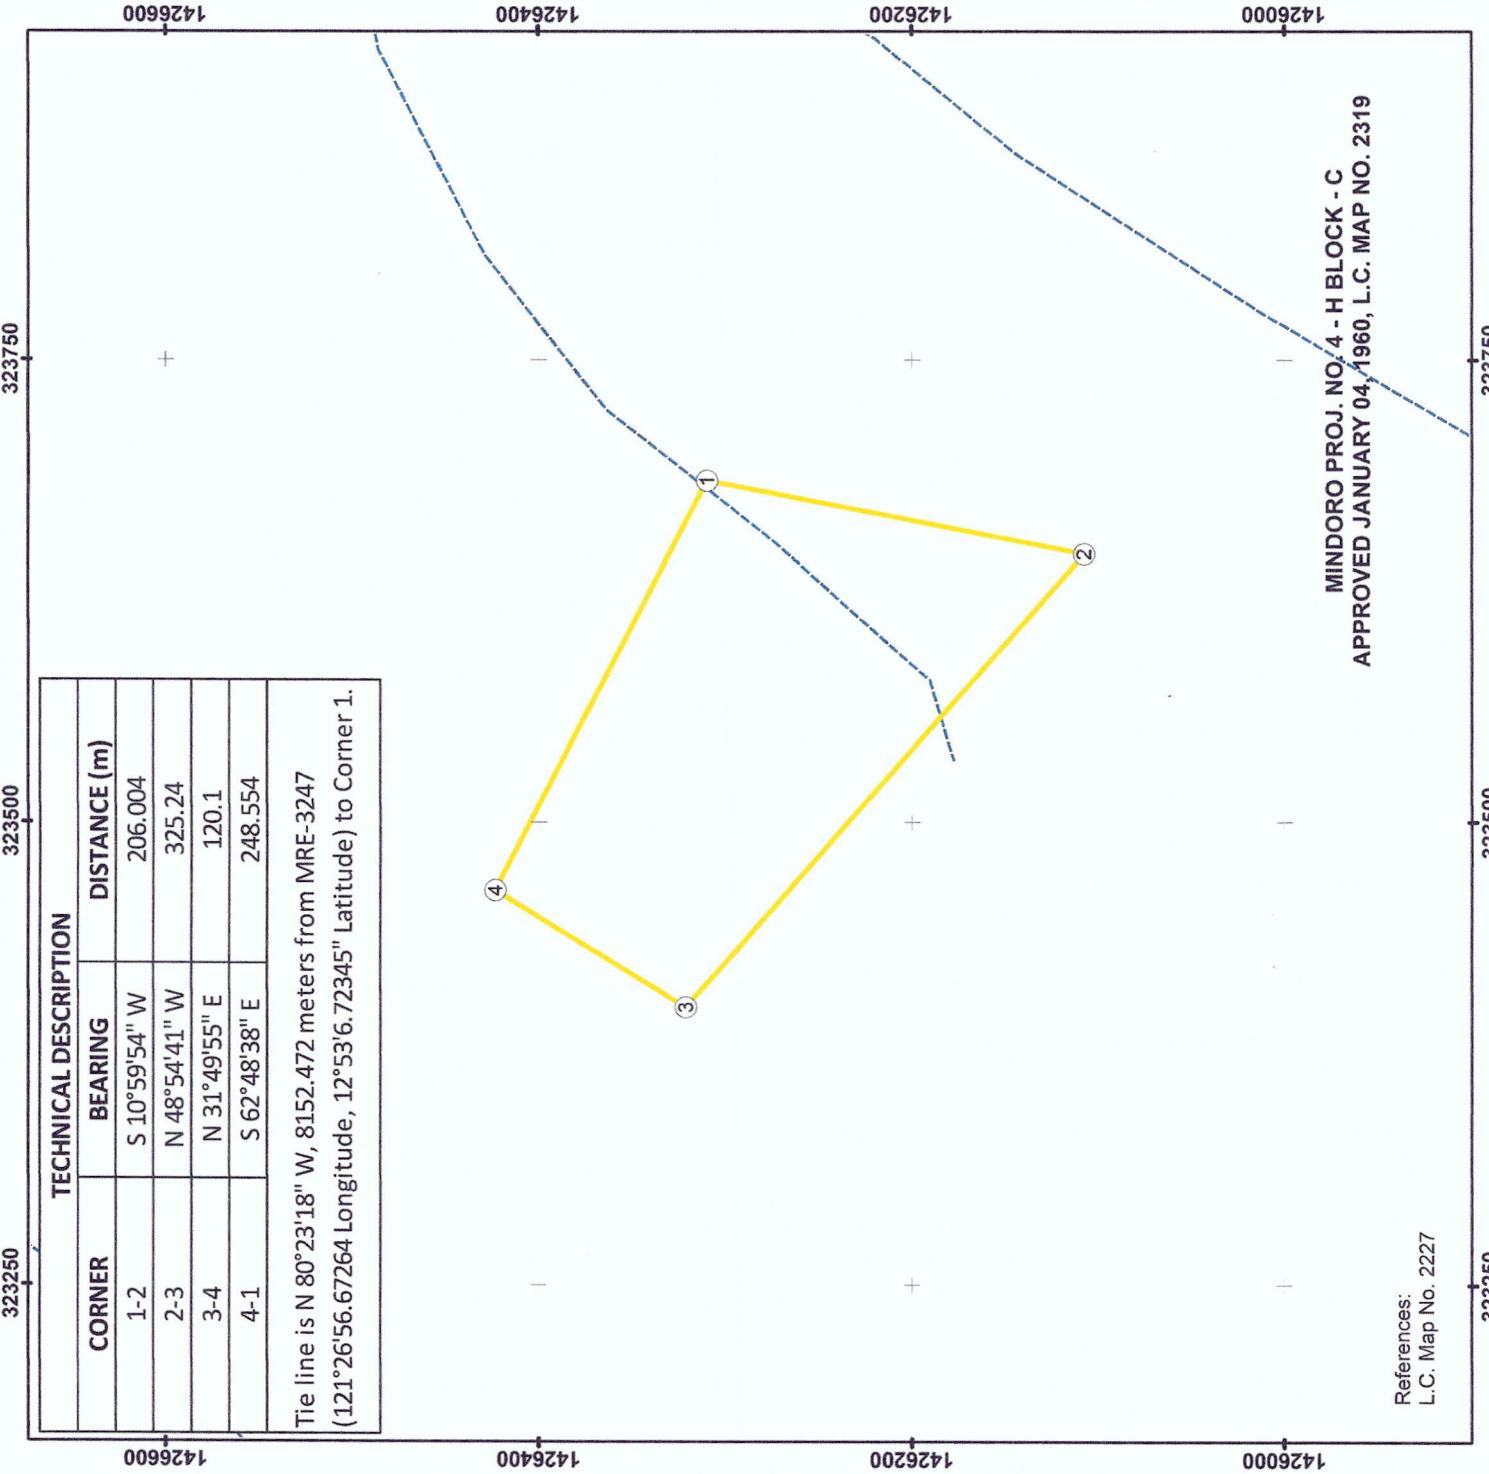

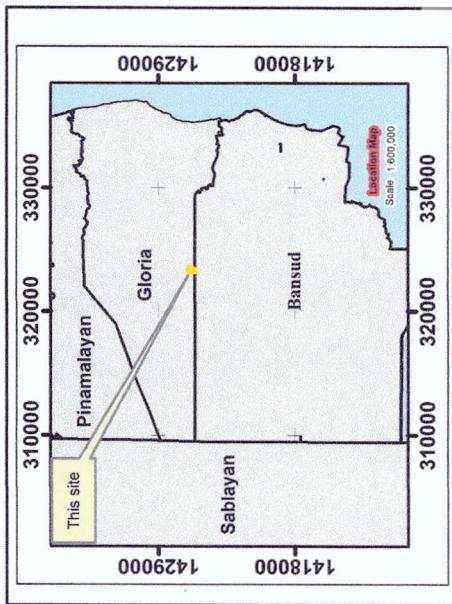

**CERTIFICATE OF STEWARDSHIP CONTRACT  
( CSC ) NO. 028553  
OF**

**CRISPIN VERA**

LOCATION: Barangay : Manguyang  
Municipality : Gloria  
Province : Oriental Mindoro

Total Area : 2.92 Hectares

Scale 1:3,000  
Spheroid..... Clarke 1886  
Projection..... Universal Transverse Mercator (Zone 51)  
Horizontal Datum..... WGS 1984

**LEGEND**

- CSC Corner
- CSC Area
- Municipal Boundary



NOTE: The political boundaries are not authoritative


**CERTIFICATION**  
Republic of the Philippines  
Department of Environment and Natural Resources  
MIMAROPA Region  
Community Environment and Natural Resources Office  
San Matano, Roxas, Oriental Mindoro


This is to certify that this is the true and correct map of the areas under Crispin Vera as described herein.  
This map was prepared based on the submitted maps, documents and other references available from this office.

Prepared by:  
*H. Lopez*  
MARIE LYN M. NGABIT  
Forester, MCBFM desk Officer  
March 13, 2023

Approved by:  
*J. Villanueva*  
ENGR. CAESAR E. QUEJEC  
CENR Officer  
March 15, 2023

Copyright 2023

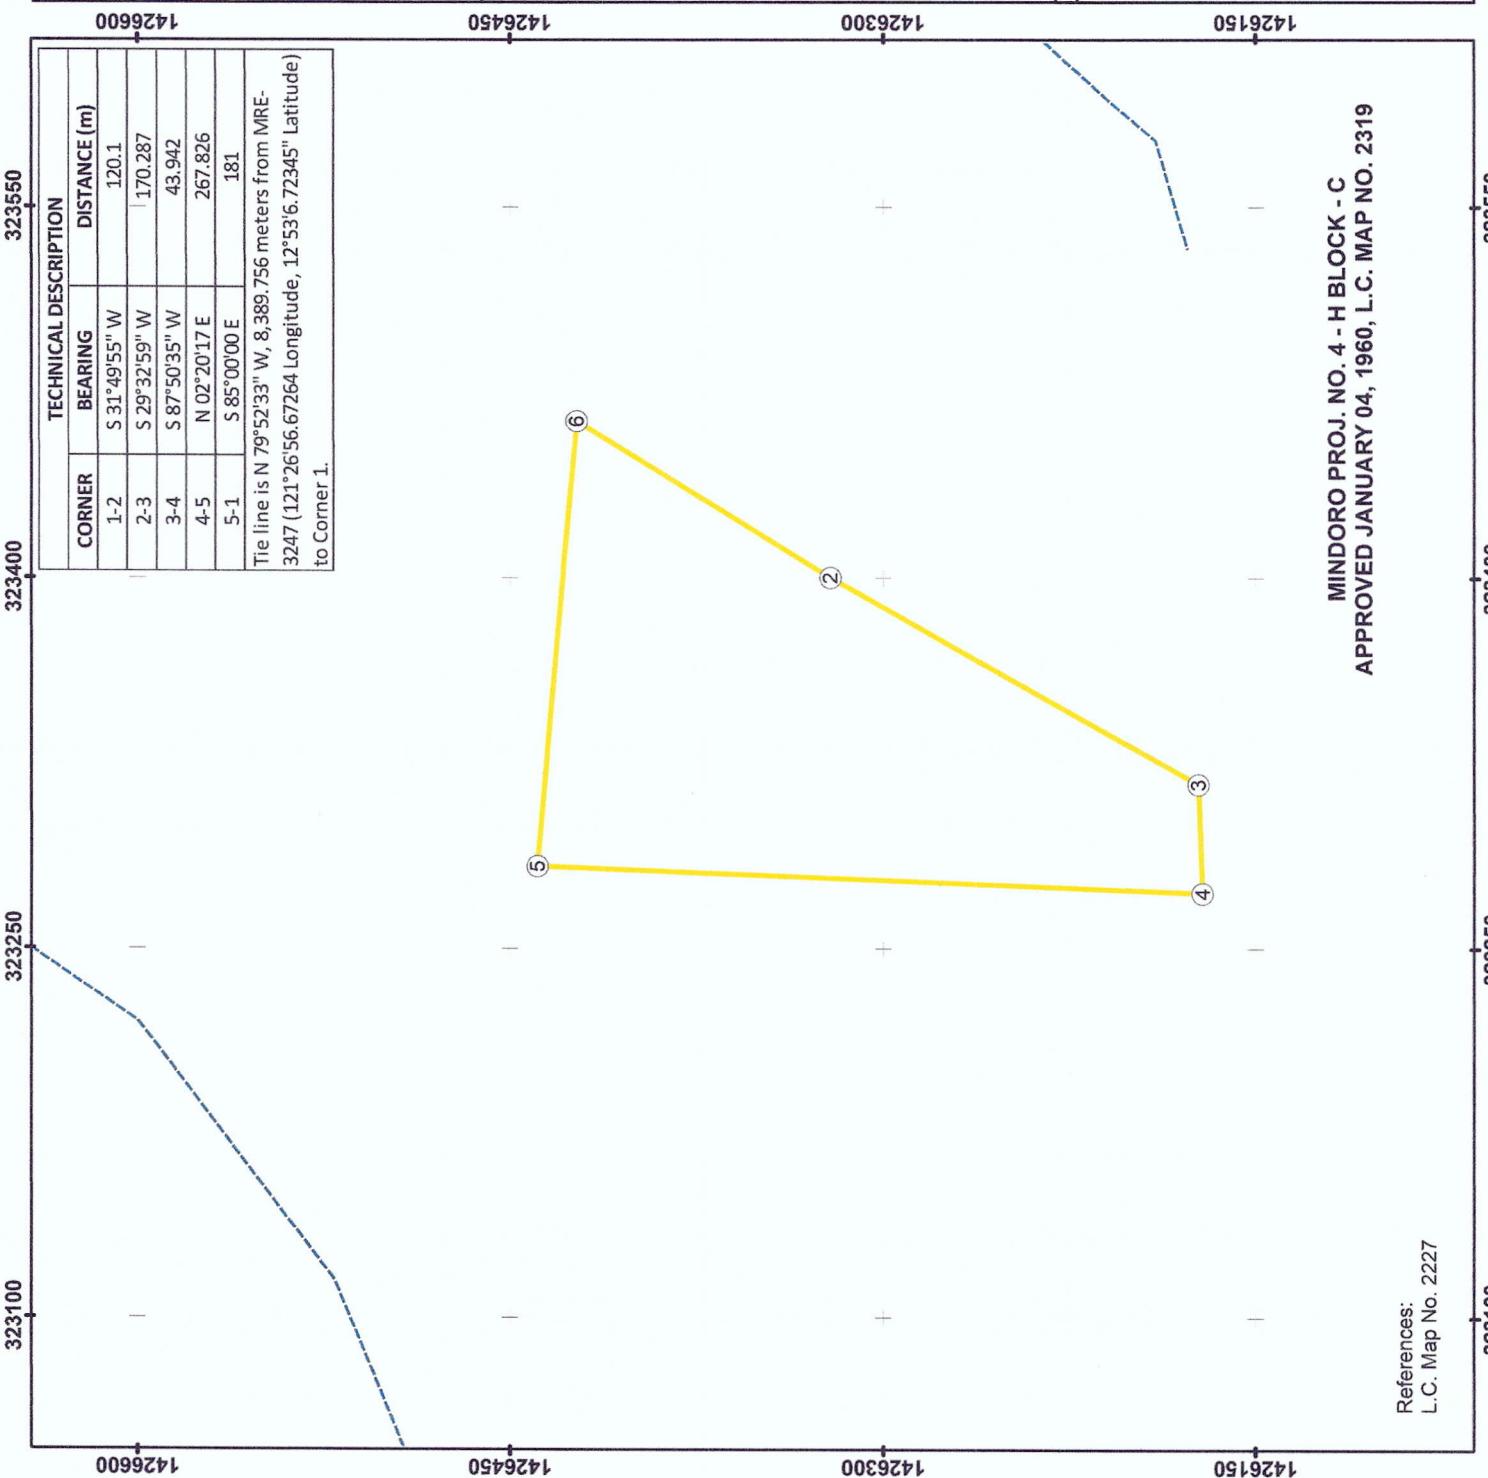

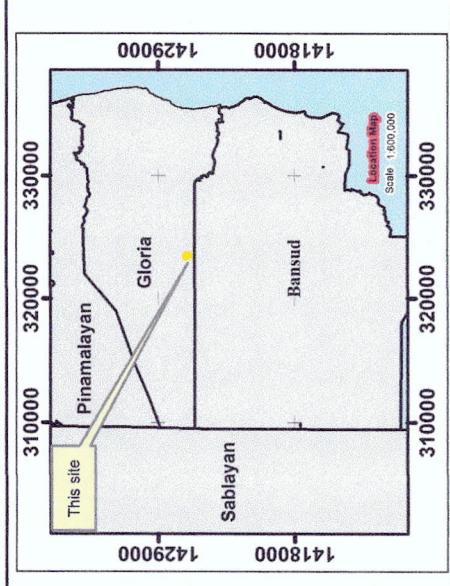

**CERTIFICATE OF STEWARDSHIP CONTRACT  
( CSC ) NO. 028547**

DOROTEA BALMES

**LOCATION:** Barangay Manguyang : Manguyang  
Municipality : Gloria  
Province : Oriental Mindoro

Total Area : 1.46 Hectares

Scale 1:2,000

Spheroid..... Clarke 1866  
 Projection..... Universal Transverse Mercator (Zone 51)  
 Horizontal Datum..... WGS 84  

| LEGEND     | Rivers and creeks | Municipal Boundary |
|------------|-------------------|--------------------|
| CSC Corner |                   |                    |
| CSC Area   |                   |                    |


Republic of the Philippines  
Department of Environment and Natural Resources  
MIMAROPA Region  
Community Environment and Natural Resources Office  
San Mariano, Roxas, Oriental Mindoro

## CERTIFICATION

This is to certify that this is the true and correct map of the areas under  
ROUTE BAINES AS DESCRIBED HEREON.  
This map was prepared based on the submitted maps, documents and  
other references available from this office.

Prepared by:

March 13, 2023  
Date

MINDORO PROJ. NO. 4 - H BLOCK - C  
APPROVED JANUARY 04, 1960 I.C. MAP NO. 23319

A

References:  
L.C. Map No. 2227


Approved by:


March 15, 2023

323600

323500  
23400

23400

323300

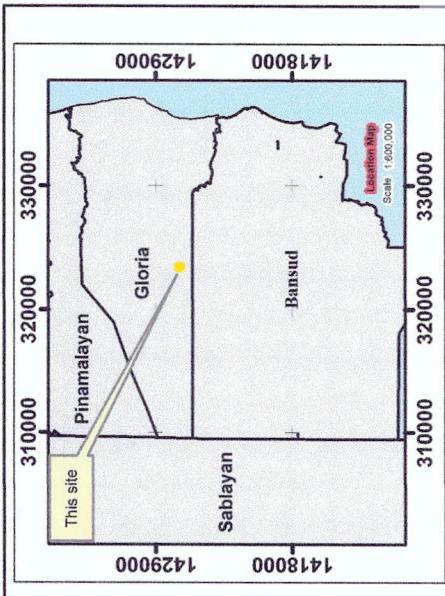

**CERTIFICATE OF STEWARDSHIP CONTRACT  
(CSC) NO. 028544  
OF**

**ESTILITO AGUADO**

**LOCATION:**  
Barangay : Manguyang  
Municipality : Gloria  
Province : Oriental Mindoro

Total Area : 3.43 Hectares

Scale 1:600,000  
Spheroid..... Clarke 1866  
Projection..... Universal Transverse Mercator (Zone 51)  
Horizontal Datum..... WGS 1984

**LEGEND**

- CSC Corner
- CSC Area
- Rivers and creeks
- Municipal Boundary

NOTE: The political boundaries are not authoritative.

Republic of the Philippines  
Department of Environment and Natural Resources  
MIMAROPA Region  
Community Environment and Natural Resources Office  
San Matano, Roxas, Oriental Mindoro

**CERTIFICATION**

This is to certify that this is the true and correct map of the areas under CERTIFICATE OF STEWARDSHIP CONTRACT (CSC) No. 028544 of Estilito Aguado as described herein.  
This map was prepared based on the submitted maps, documents and other references available from this office.

Prepared by:

*[Signature]*  
MARIE L. NGABIT  
Forester  
CENR desk Officer

Approved by:


*[Signature]*  
ENGR. CESAR E. QUEBEE  
CENR Officer

MINDORO PROJ. NO. 4 - H BLOCK - C

APPROVED JANUARY 04, 1960, L.C. MAP NO. 2319


References:  
L.C. Map No. 2227

323400 323550 323250 3233400 1427350 1427200 1427050 1426900 323250 3233400 1427350 1427200 1427050 1426900 323400 323550

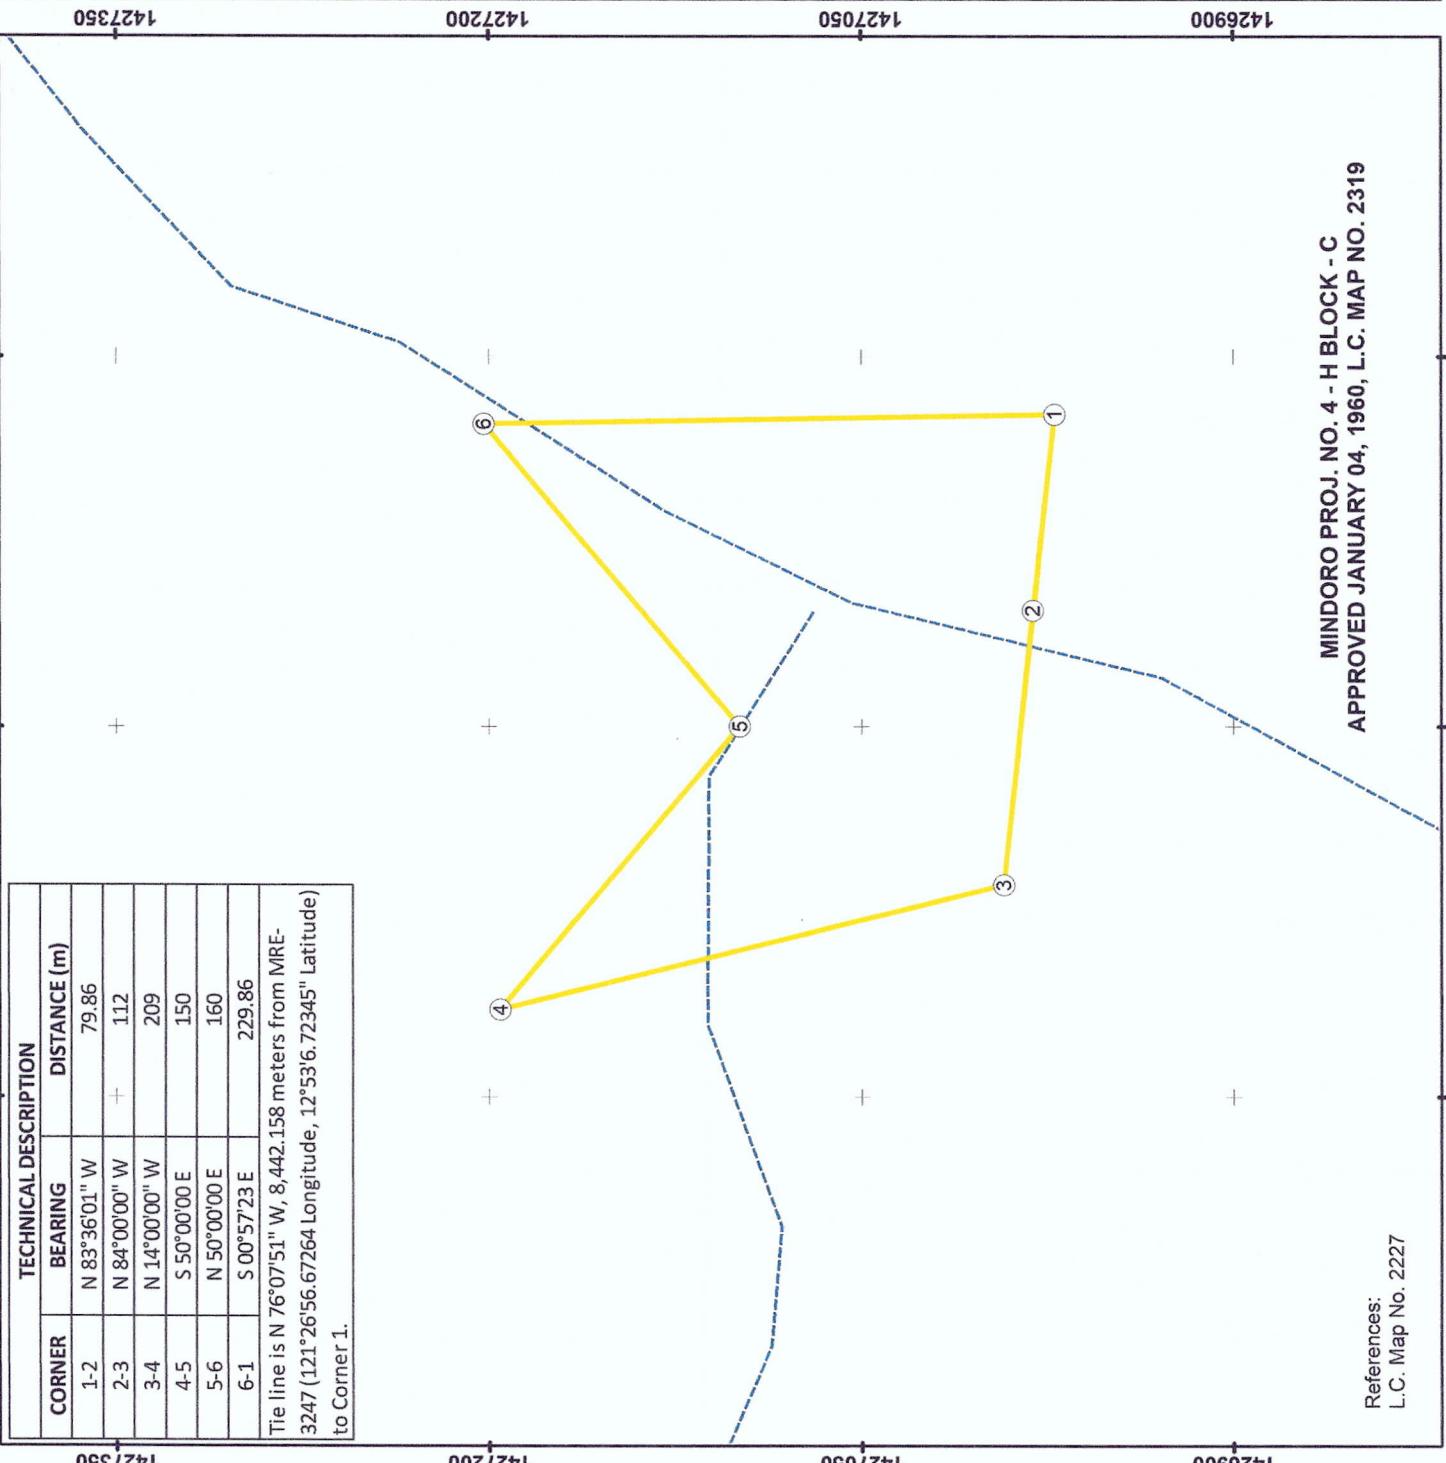

323400 323550 323250 3233400 1427350 1427200 1427050 1426900 323400 323550

Copyright 2023

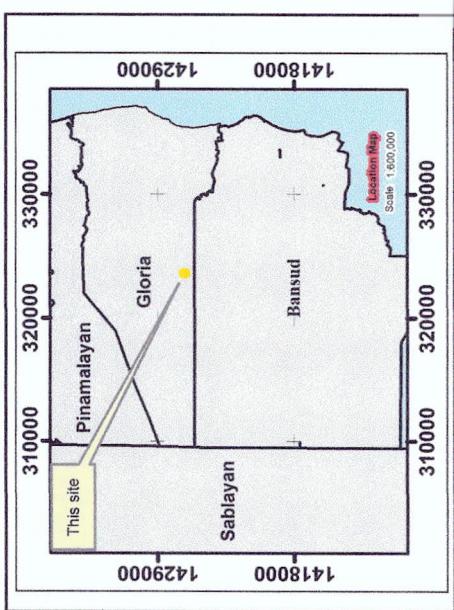

**CERTIFICATE OF STEWARDSHIP CONTRACT  
( CSC ) NO. 028542  
OF**

**FAUSTINO SALUDES**

LOCATION: Barangay : Manguyang  
Municipality : Gloria  
Province : Oriental Mindoro

Total Area : 4.62 Hectares

Scale 1:50,000  
Spheroid..... Clarke 1880  
Projection..... Universal Transverse Mercator (Zone 51)  
Horizontal Datum..... WGS 1984

**LEGEND**

- CSC Corner
- CSC Area
- Rivers and creeks
- Municipal Boundary

NOTE: The political boundaries are not authoritative

1426900 1427050 142750 1426750

**CERTIFICATION**

This is to certify that this is the true and correct map of the areas under CERTIFICATE OF STEWARDSHIP CONTRACT ( CSC ) No. 028542 of Faustino Saludes as described herein.  
This map was prepared based on the submitted maps, documents and other references available from this office.

Prepared by:

**MARCELO M. NGABIT**  
Forester/CFCFM desk Officer

March 13, 2023  
Date

**ENGR. CAESAR E. QUEBEC**  
CENR Officer

March 15, 2023  
Date

Copyright 2023

**MINDORO PROJ. NO. 4 - H BLOCK - C  
APPROVED JANUARY 04, 1960, L.C. MAP NO. 2319**

References:  
L.C. Map No. 2227


323850

323700

323550

323400

323300

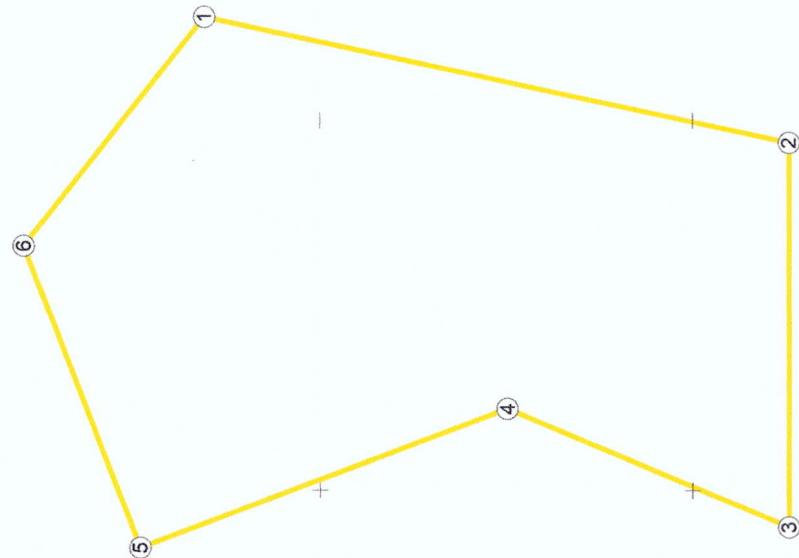

323850

323700

323550


323400

323300

1427050 1426900 142750 1426750

1426900 1427050 142750 1426750

Copyright 2023

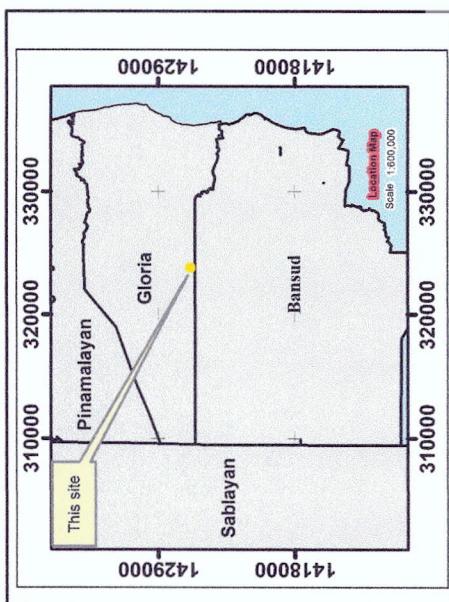

**CERTIFICATE OF STEWARDSHIP CONTRACT  
( CSC ) NO. 028550**

FELINO MAGTIBAY

**LOCATION:** Barangay : Manguyang  
Municipality : Gloria  
Province : Oriental Mindoro

Total Area : 2.79 Hectares

Scale 1:3,000



**LEGEND**

- CSC Corner
- CSC Area
- Rivers and creeks
- Municipal Boundary

Republic of the Philippines  
Department of Environment and Natural Resources  
MAYAROPA Region  
Community Environment and Natural Resources Office  
San Mariano, Oriental Mindoro

## CERTIFICATION


This is to certify that this is the true and correct map of the areas under  
This map was prepared based on the submitted maps, documents and


**Prepared by:**  **MARLENE NGABIT**  
Forester CBFM desk Officer  
**Date** March 13, 2023

Approved by: *Connelly*  
ENGR. CESAR E. QUEBELL  
CFN Officer

March 15, 2023  
Date

Copyright

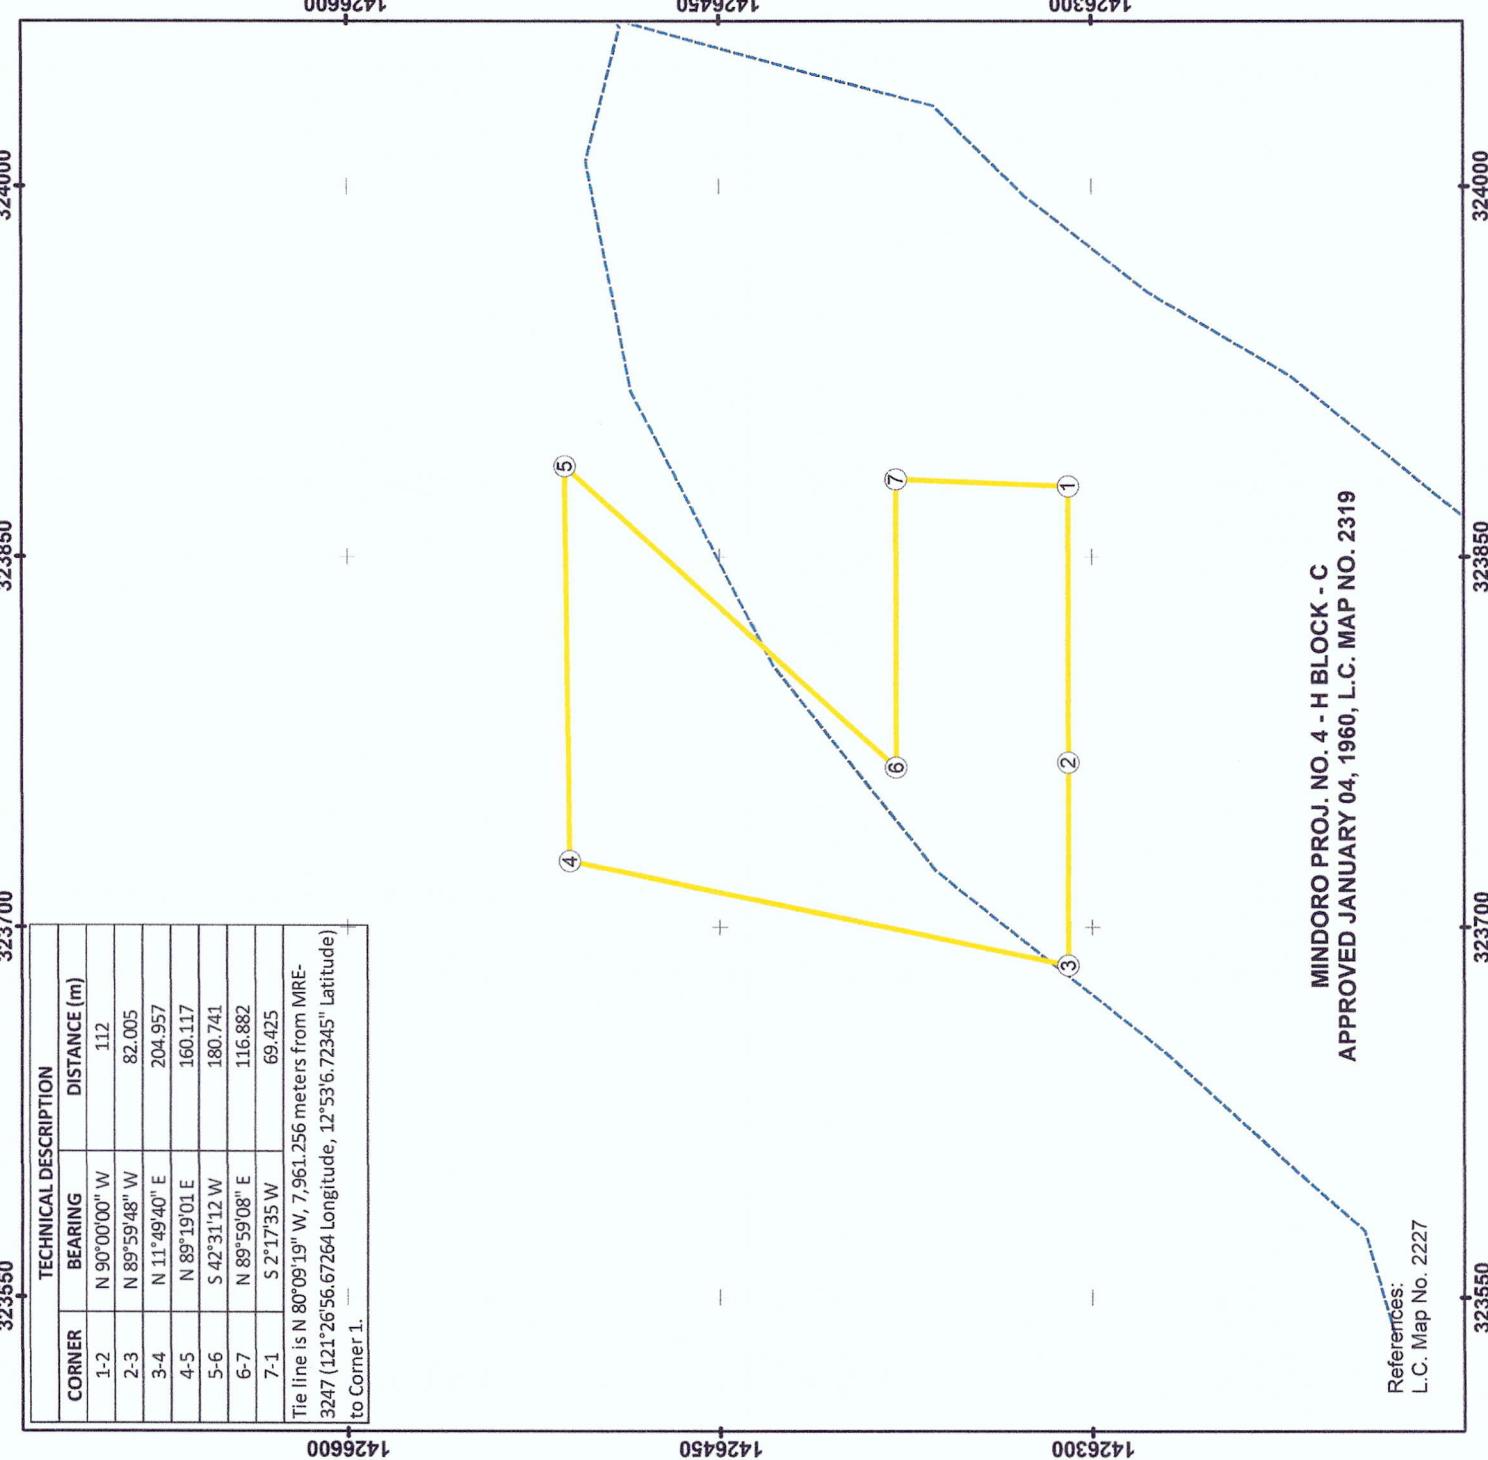

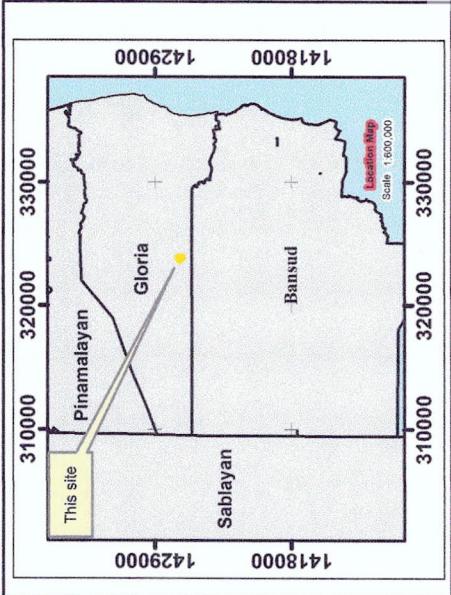

1427200 1427050 1427050 1426900 1426900

| TECHNICAL DESCRIPTION |               |              |
|-----------------------|---------------|--------------|
| CORNER                | BEARING       | DISTANCE (m) |
| 1-2                   | N 51°44'47" W | 166.914      |
| 2-3                   | N 52°00'00" W | 118          |
| 3-4                   | N 69°00'00" E | 240          |
| 4-1                   | S 00°00'00 E  | 262          |

Tie line is N 76°25'51" W, 8,075.075 meters from MRE-3247/121°26'56.67264 Longitude, 12°53'6.72345" Latitude) to Corner 1.

324000

323850

323700

323550

1427200

1427050

1426900

324000

323850

323550

CERTIFICATE OF STEWARDSHIP CONTRACT  
(CSC) NO. 028541  
OF

**GUMERSINDO LIPAT**

LOCATION: Barangay : Manguyang  
Municipality : Gloria  
Province : Oriental Mindoro

Total Area : 2.93 Hectares

Scale 1:3,000  
0 2,625 5,250 10,000 15,750 21,500  
Metres  
Spheroid..... Clarke 1866  
Projection..... Universal Transverse Mercator (Zone 51)  
Horizontal Datum..... WGS 1984

LEGEND

- CSC Corner
- Rivers and creeks
- CSC Area
- Municipal Boundary

NOTE: The political boundaries are not authoritative



Republic of the Philippines  
Department of Environment and Natural Resources

Region V  
Community Environment and Natural Resources Office

San Mariano, Roxas, Oriental Mindoro

**CERTIFICATION**

This is to certify that this is the true and correct map of the areas under CERTIFICATE OF STEWARDSHIP CONTRACT (CSC) No. 028541 of Gumersindo Lipat as described herein.


This map was prepared based on the submitted maps, documents and other references available from this office.

Prepared by:  
  
MARILOU M. NGABIT  
Forester M/CENR desk Officer  
March 13, 2023

Approved by:  
  
CAESAR E. QUIBUS  
CENR Officer  
March 15, 2023

**MINDORO PROJ. NO. 4 - H BLOCK - C**  
**APPROVED JANUARY 04, 1960, L.C. MAP NO. 2319**

References:  
L.C. Map No. 2227

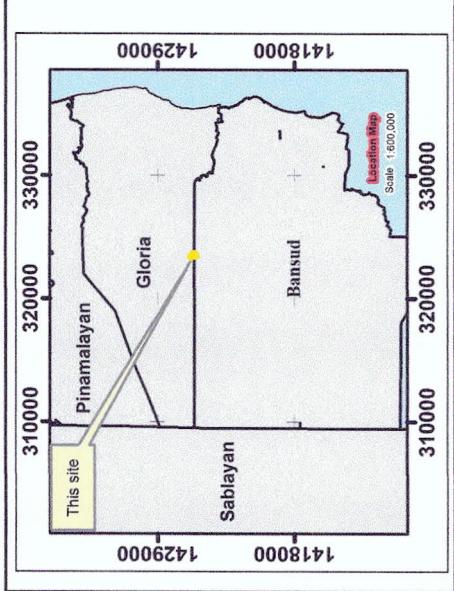

CERTIFICATE OF STEWARDSHIP CONTRACT  
(CSC) NO. 028563  
OF

**JESUS RONCALI**

LOCATION: Barangay : Manguyang  
Municipality : Gloria  
Province : Oriental Mindoro

Total Area : 4.10 Hectares

Scale 1:3,000  
0 2,400 4,800 7,200 9,600 12,000  
Metres  
Spheroid.....Clarke 1866  
Projection.....Universal Transverse Mercator (Zone 51)  
Horizontal Datum.....WGS 1984

LEGEND

- CSC Corner
- CSC Area
-  Municipal Boundary
-  Rivers and creeks

NOTE: The political boundaries are not authoritative.

Republic of the Philippines  
Department of Environment and Natural Resources  
MIMAROPA Region  
Community Environment and Natural Resources Office  
San Manalo, Roxas, Oriental Mindoro

CERTIFICATION


This is to certify that this is the true and correct map of the areas under CERTIFICATE OF STEWARDSHIP CONTRACT (CSC) No. 028563 of Jesus Roncali as described herein.  
This map was prepared based on the submitted maps, documents and other references available from this office.


Prepared by:

  
**MAREY M. NGABIT**  
Forester/CSCFM desk Officer  
March 13, 2023  
Date

  
**ENGR. CESARE QUEBEC**  
CENR Officer  
March 15, 2023  
Date

Copyright 2023

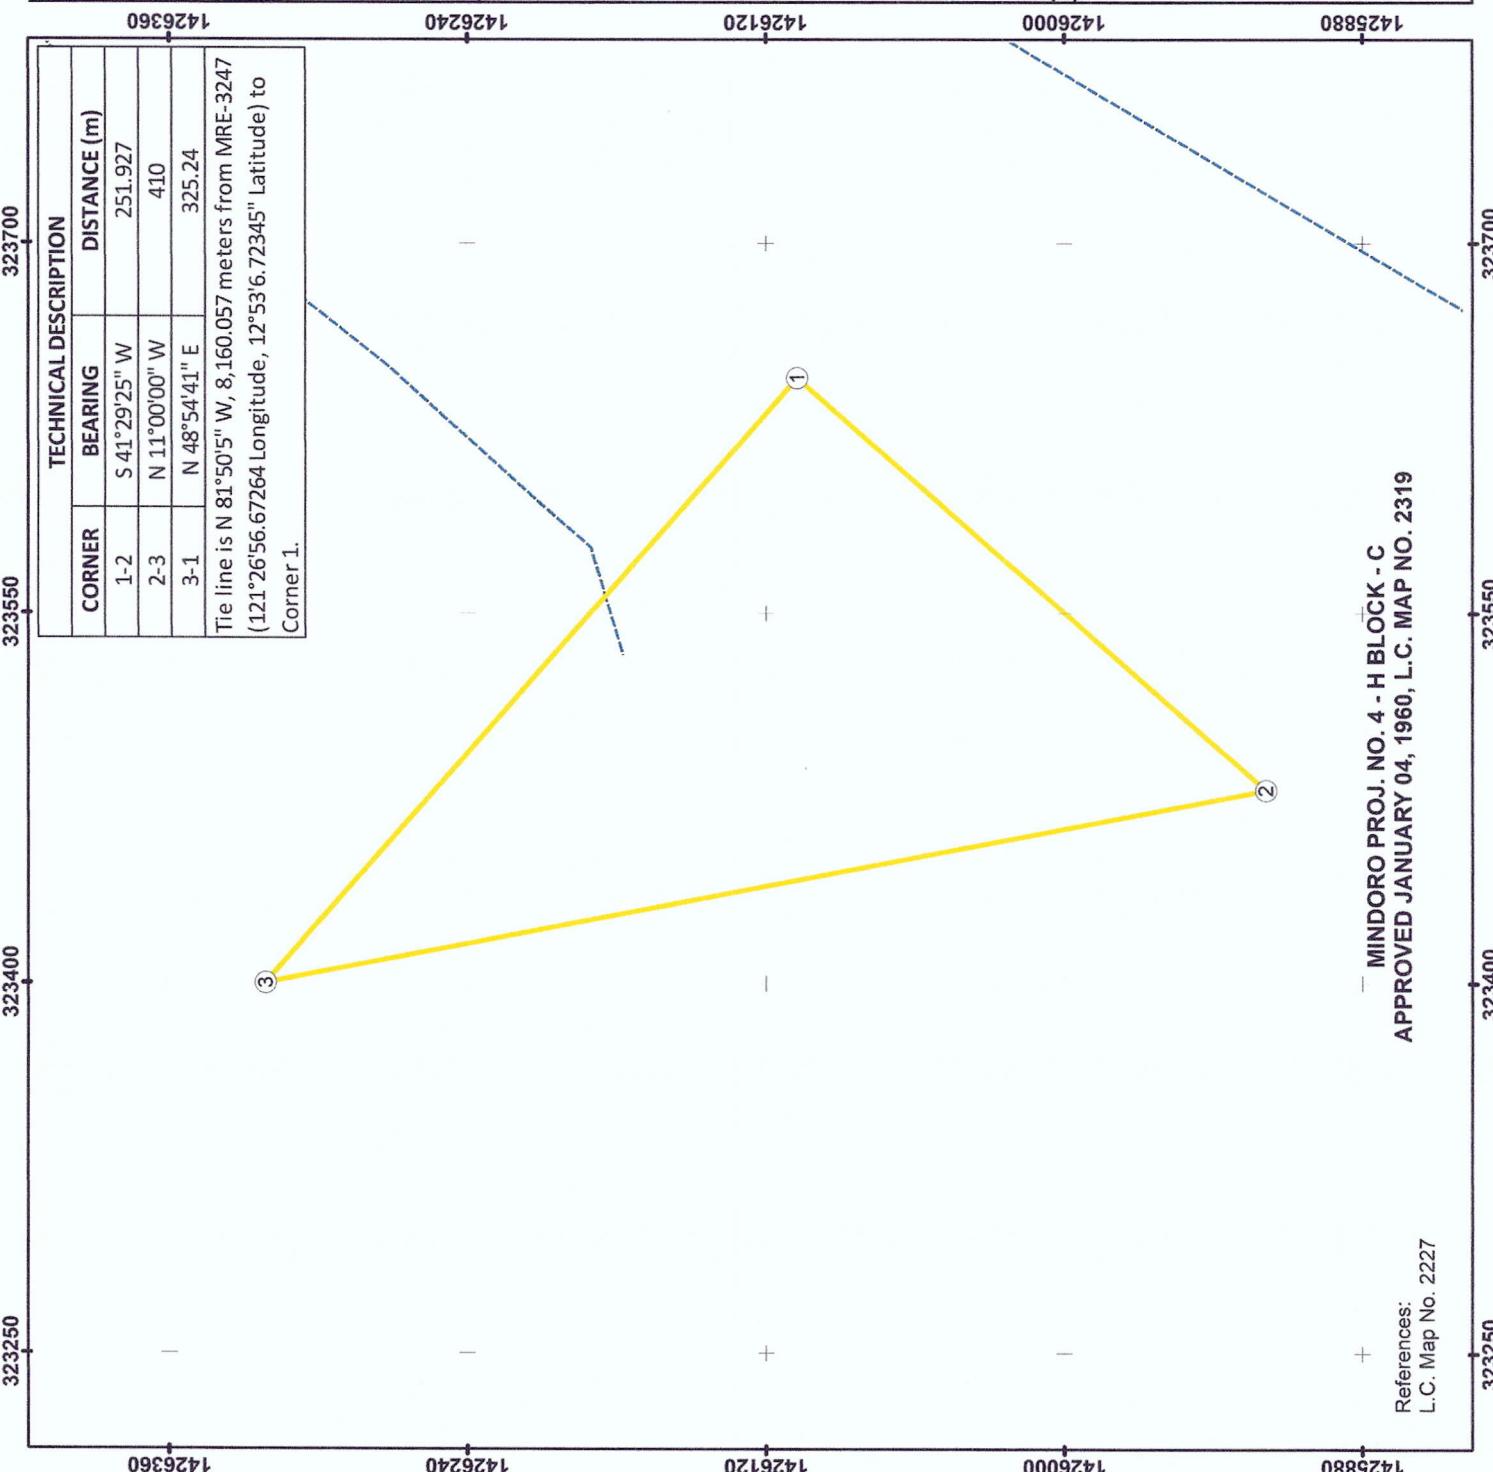

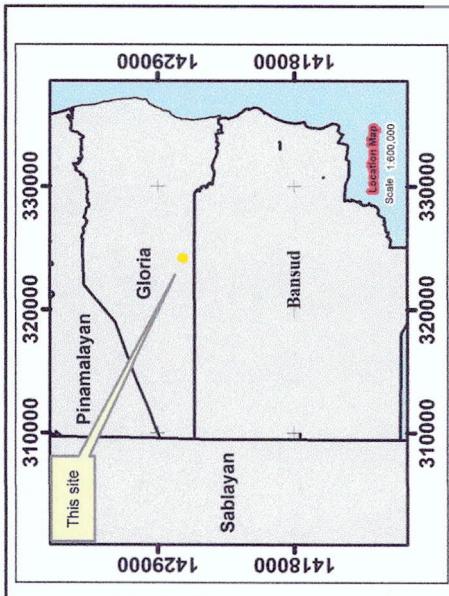

CERTIFICATE OF STEWARDSHIP CONTRACT  
(CSC) NO. 028538  
OF

**NATALIO PALMA**

LOCATION: Barangay : Manguyang  
Municipality : Gloria  
Province : Oriental Mindoro

Total Area : 3.67 Hectares

Scale 1:3,000  
0 - 300 - 600 - 900 - 1200 - 1500 - 1800 - 2100  
Meters  
Projection.....Universal Transverse Mercator (Zone 1)  
Horizontal Datum.....WGS 1984

LEGEND

- CSC Corner
- CSC Area
- Municipal Boundary
- Rivers and creeks

NOTE: The political boundaries are not authoritative



**CERTIFICATION**


This is to certify that this is the true and correct map of the areas under CERTIFICATE OF STEWARDSHIP CONTRACT (CSC) No. 028538 of Natalio Palma as described herein.  
This map was prepared based on the submitted maps, documents and other references available from this office.


Prepared by:

MARIE L. NGABIT  
Forester I  
ENR Officer  
March 13, 2023

J. M. QUEBEC  
ENGR. CAESAR E. QUEBEC  
ENR Officer  
March 15, 2023

Copyright 2023

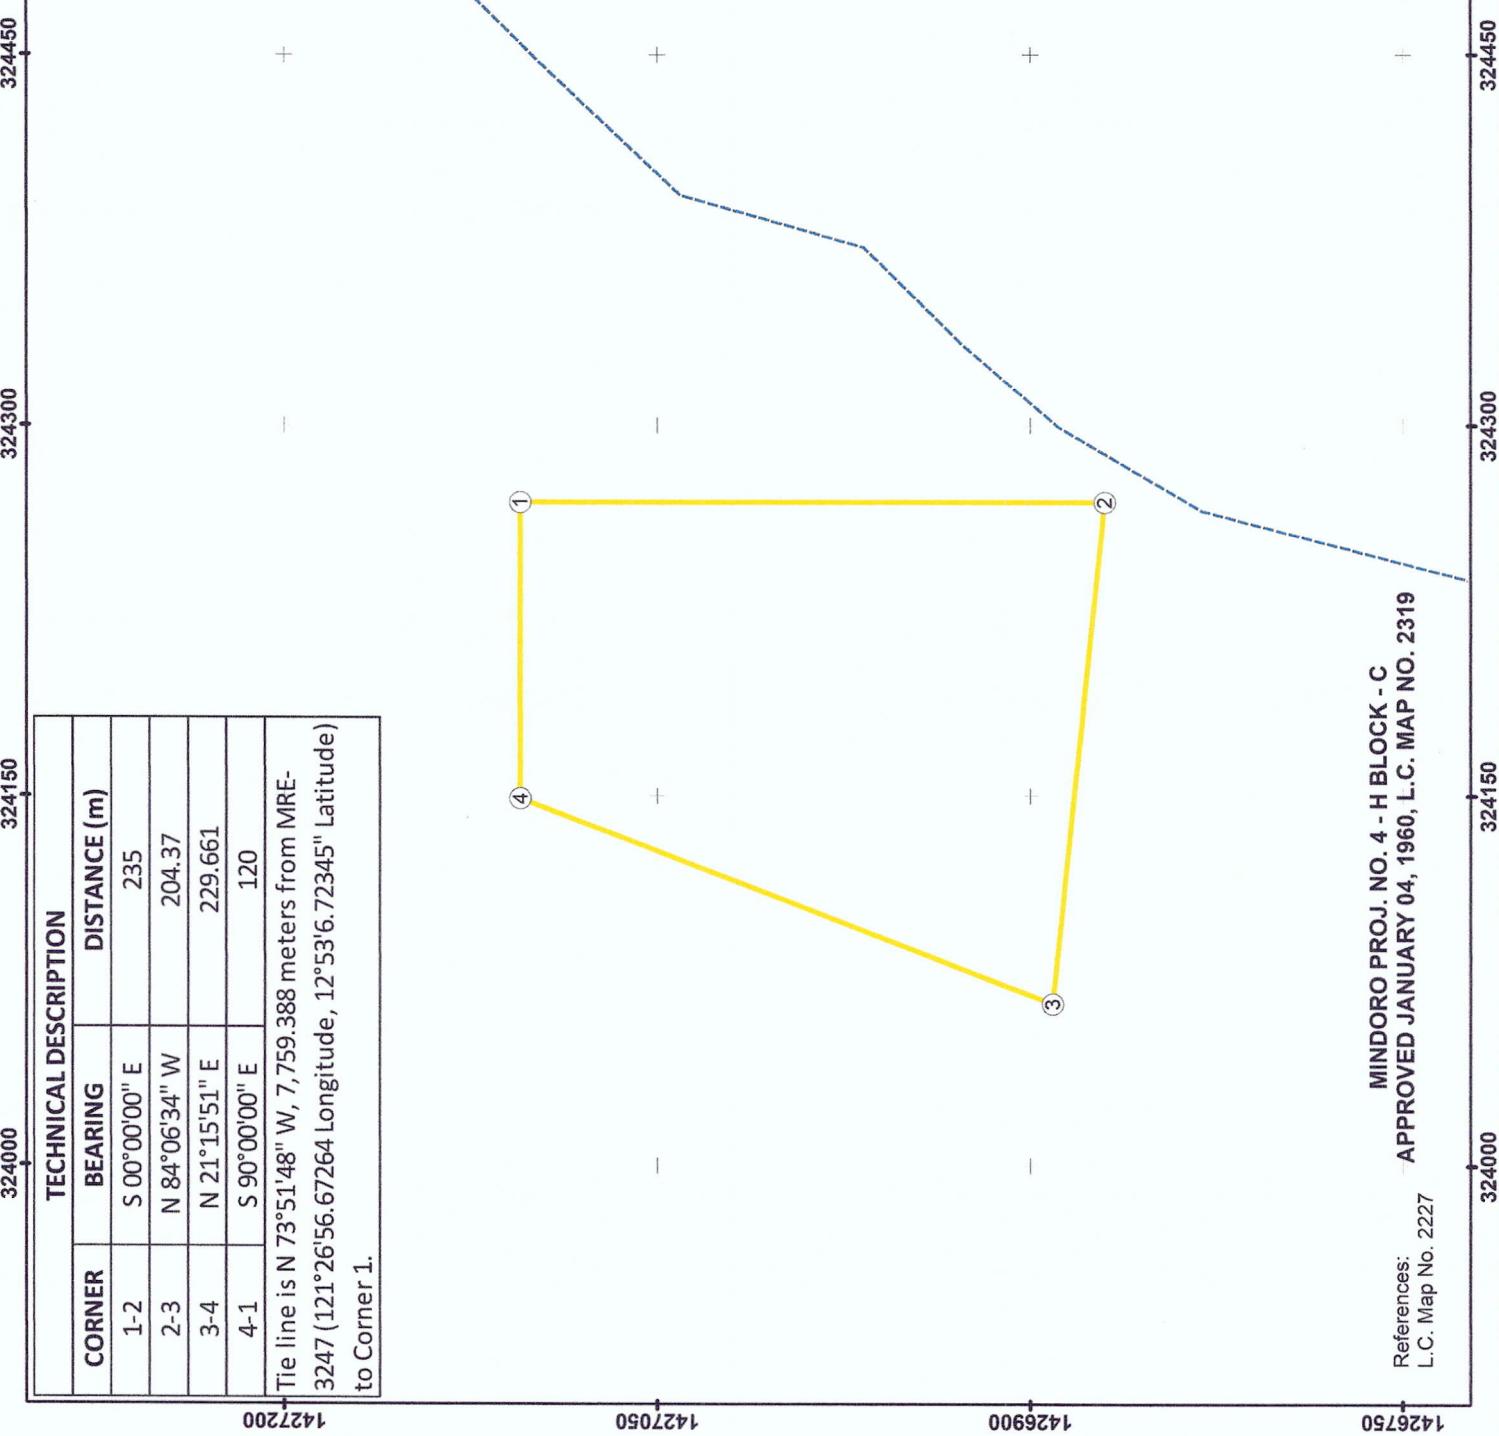

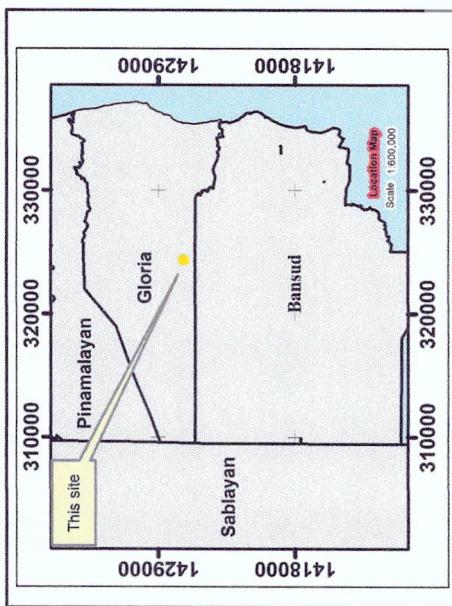

CERTIFICATE OF STEWARDSHIP CONTRACT  
(CSC) NO. 028537  
OF

**PORFERIO PALMA**

LOCATION:  
Barangay : Manguyang  
Municipality : Gloria  
Province : Oriental Mindoro

Total Area : 4.25 Hectares

Scale 1:20,000  
Spheroid.....Clarke 1866  
Projection.....Universal Transverse Mercator (Zone 51)  
Horizontal Datum.....WGS 1984

LEGEND

- CSC Corner
- CSC Area
- Rivers and creeks
- Municipal Boundary

NOTE: The political boundaries are not authoritative

1426900

CERTIFICATION

This is to certify that this is the true and correct map of the areas under CERTIFICATE OF STEWARDSHIP CONTRACT (CSC) No. 028537 of Porferio Palma as described herein.  
This map was prepared based on the submitted maps, documents and other references available from this office.

Prepared by:

MARIE LYNNE, NGABIT  
Forester / BIM desk Officer


March 13, 2023  
Date


March 15, 2023  
Date

References:  
L.C. Map No. 2227

MINDORO PROJ. NO. 4 - H BLOCK - C  
APPROVED JANUARY 04, 1960, L.C. MAP NO. 2319  
324600 324450 324300 324150

Copyright 2023

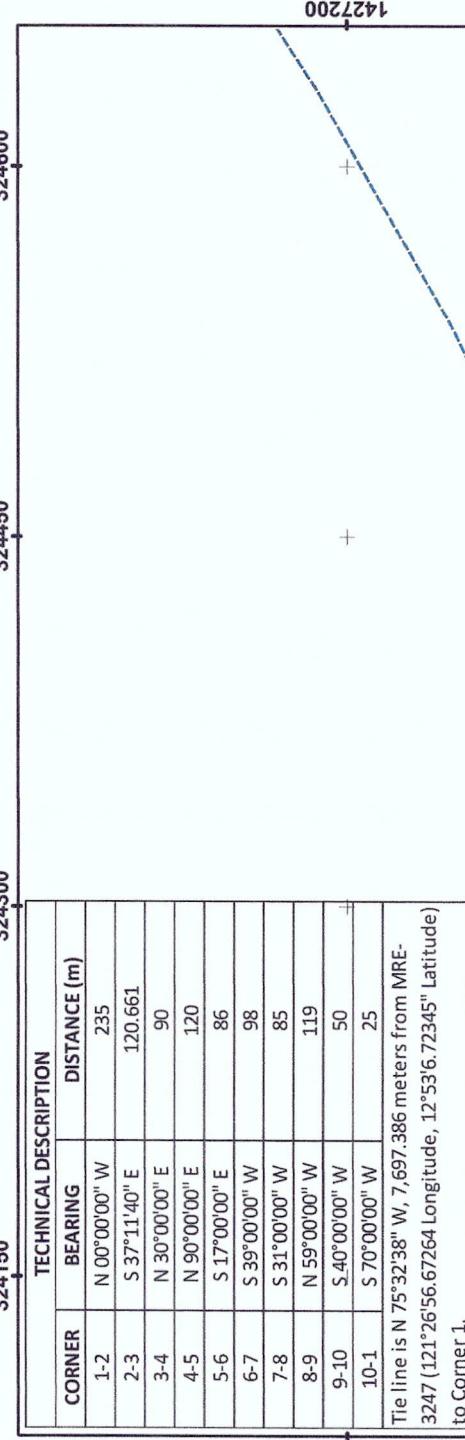

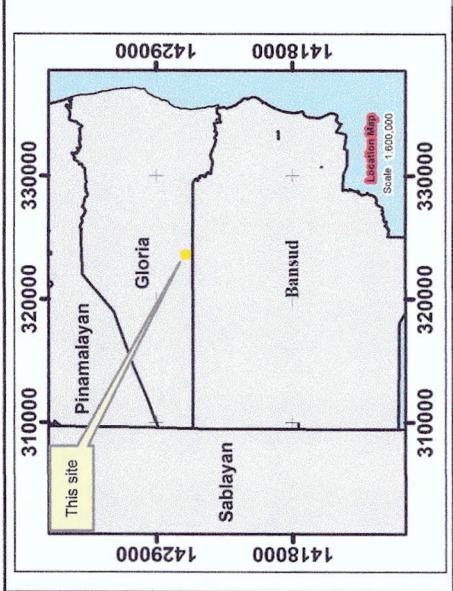

**CERTIFICATE OF STEWARDSHIP CONTRACT  
(CSC) NO. 028548  
OF**

**ROBERT EVORA**

LOCATION: Barangay : Manguyang  
Municipality : Gloria  
Province : Oriental Mindoro

Total Area : 3.74 Hectares

Scale 1:3,000  
0 240 480 720 960 1200 1440 1680  
Meters  
Sphereid..... Clarke 1888  
Projection..... Universal Transverse Mercator (Zone 51)  
Horizontal Datum..... WGS 1984

**LEGEND**  
 CSC Corner       CSC Area       Rivers and creeks       Municipal Boundary

NOTE: The political boundaries are not authoritative.

**CERTIFICATION**  
 Republic of the Philippines  
 Department of Environment and Natural Resources  
 MIMAROPA Region  
 Community Environment and Natural Resources Office  
 San Matano, Roxas, Oriental Mindoro

**CERTIFICATION**

This is to certify that this is the true and correct map of the areas under  
CERTIFICATE OF STEWARDSHIP CONTRACT (CSC) No. 028548 of  
Robert Evora as described hereon.  
This map was prepared based on the submitted maps, documents and  
other references available from this office.

Prepared by:

**MARELLA M. NGABIT**  
 Forester/CBM desk Officer


Approved by:  
**OPALIAK**  
 ENGR. CESAR E. QUEBED  
 CENR Officer


**MINDORO PROJ. NO. 4 - H BLOCK - C**

**APPROVED JANUARY 04, 1960, L.C. MAP NO. 2319**

References:  
 L.C. Map No. 2227

Copyright 2023  
 March 13, 2023  
 Date  
 March 15, 2023  
 Date  
 Copyright 2023

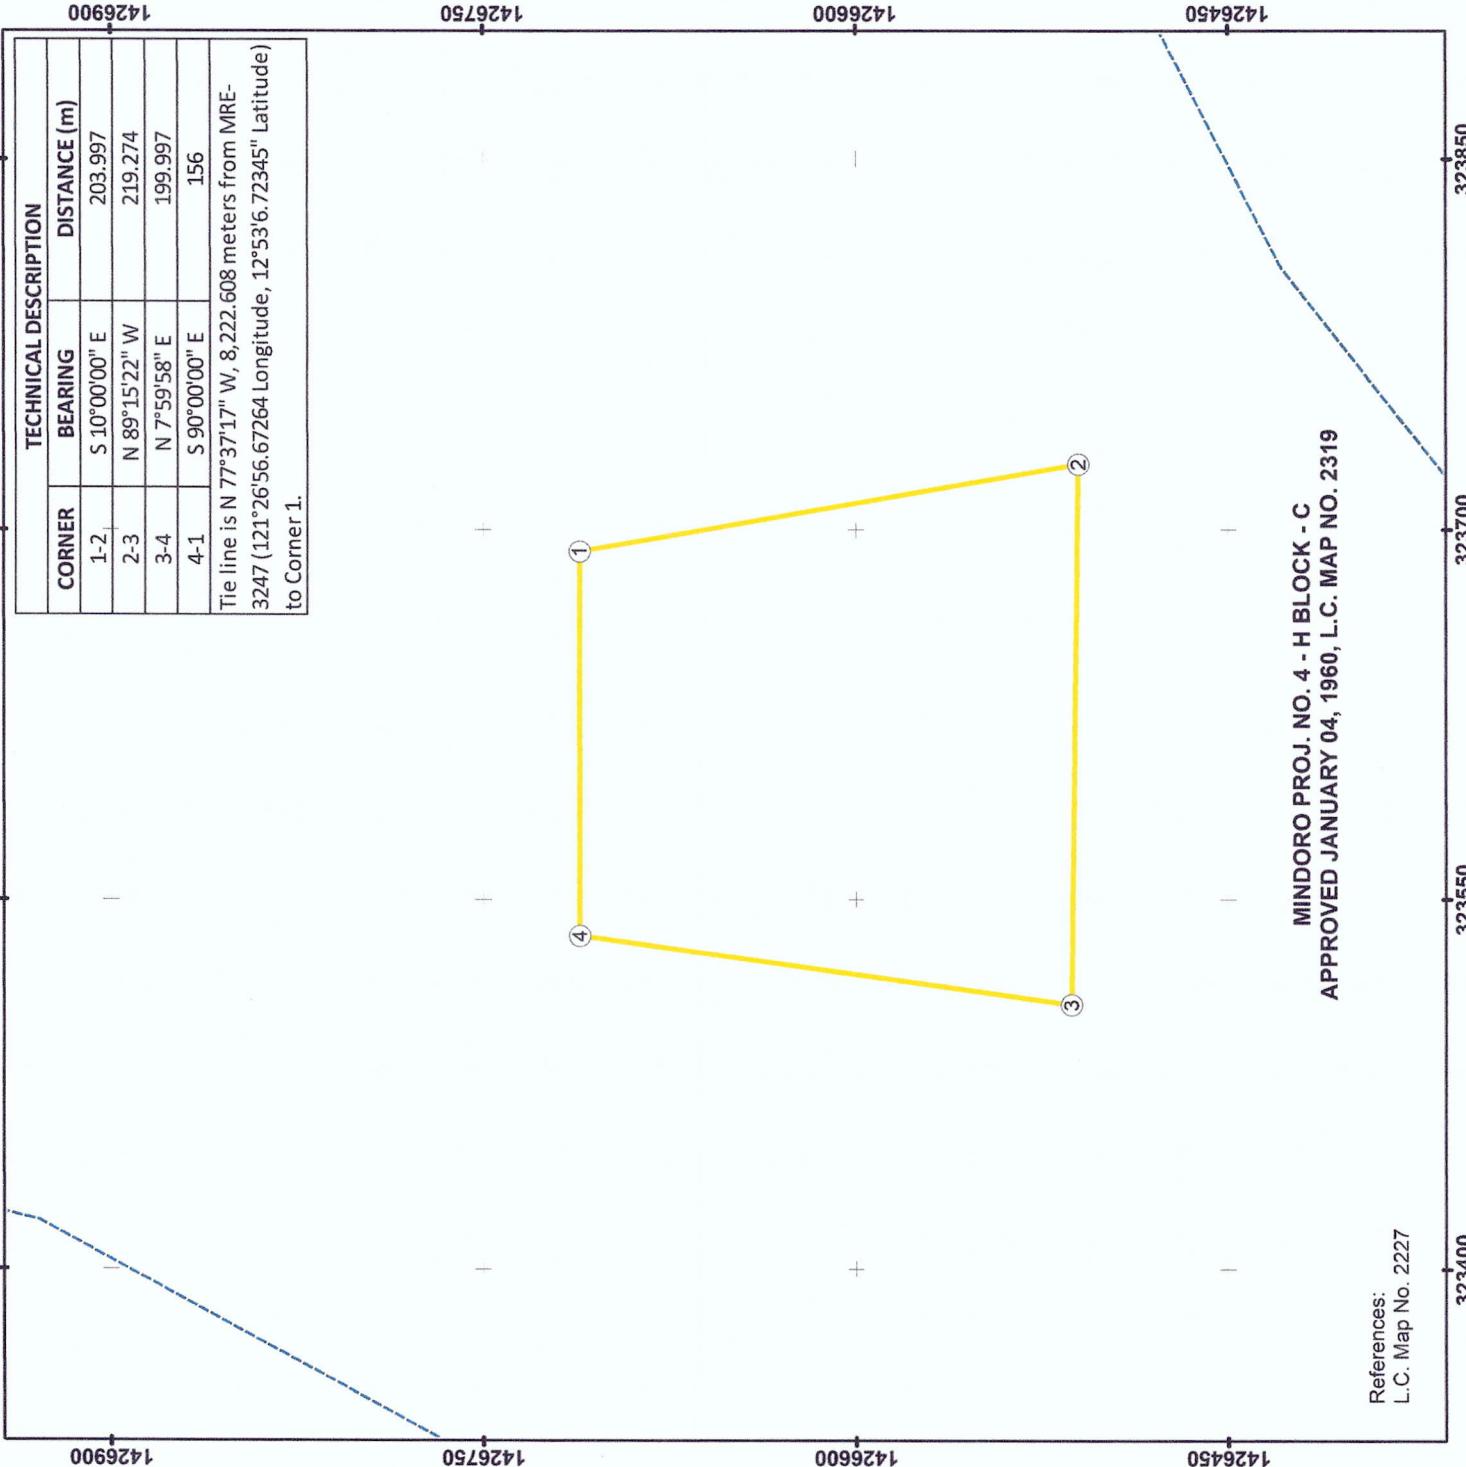

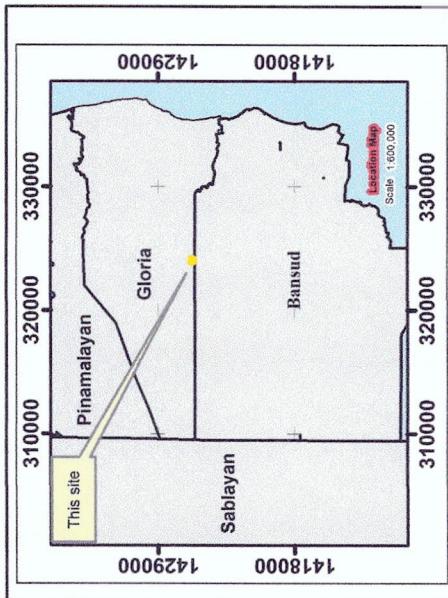

CERTIFICATE OF STEWARDSHIP CONTRACT  
(CSC) NO. 028557  
OF

RUSTICO MANALO

LOCATION: Barangay : Manguyang  
Municipality : Gloria  
Province : Oriental Mindoro

Total Area : 3.01 Hectares

Scale 1:3,000  
0 1000 2000 3000 4000 5000  
Metres  
Spheroid..... Clarke 1886  
Projection..... Universal Transverse Mercator (Zone 51)  
Horizontal Datum..... WGS 1984

LEGEND

- CSC Corner
- CSC Area
- Rivers and creeks
- Municipal Boundary

NOTE: The political boundaries are not authoritative

Republic of the Philippines  
Department of Environment and Natural Resources  
MIMAROPA Region  
Community and Natural Resources Office  
San Matano, Roxas, Oriental Mindoro

CERTIFICATION

This is to certify that this is the true and correct map of the areas under  
CERTIFICATE OF STEWARDSHIP CONTRACT CSC No. 028557 of  
Rustico Manalo as described herein.  
This map was prepared based on the submitted maps, documents and  
other references available from this office.

Prepared by:


MARIE JEANNE M. NGABIT  
Forester  
CSC/CFBM desk Officer

March 13, 2023  
Date



ENGR. CAESAR E. QUEBEB  
CENR Officer

March 15, 2023  
Date

Copyright 2023

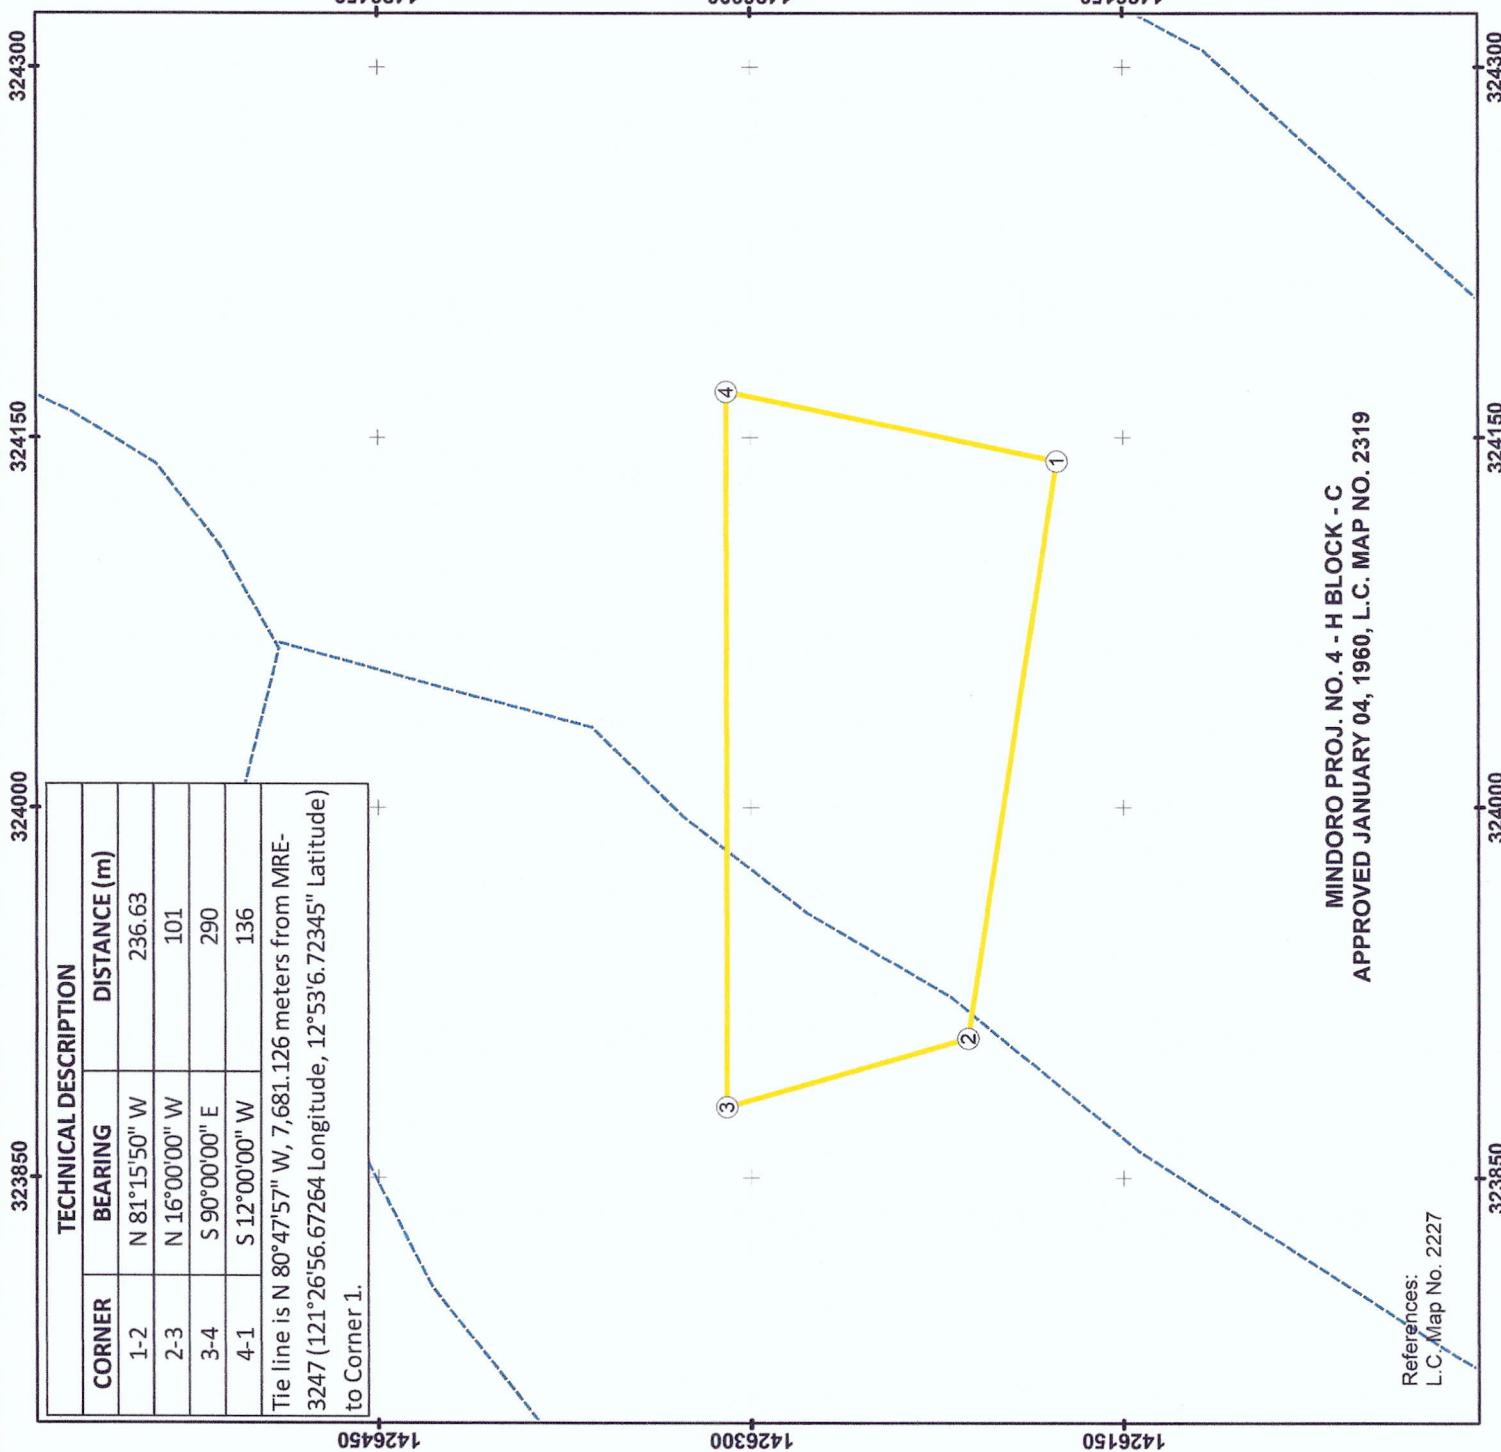



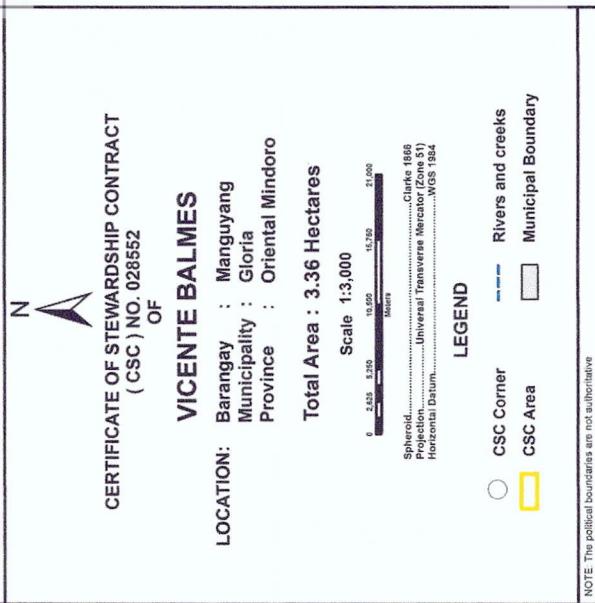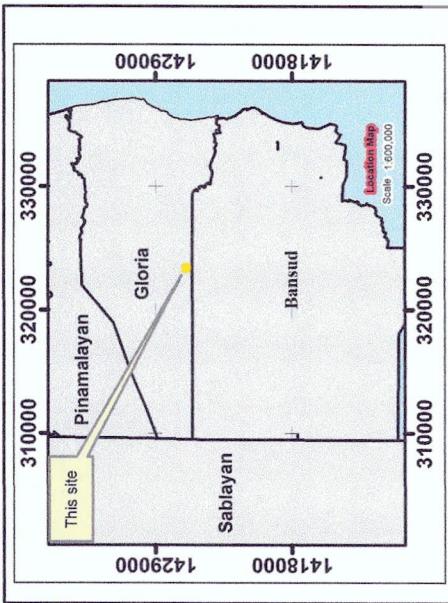

**CERTIFICATION**


This is to certify that this is the true and correct map of the areas under CERTIFICATE OF STEWARDSHIP CONTRACT (CSC) No. 028552 of Vicente Balmes as described herein.


This map was prepared based on the submitted maps, documents and other references available from this office.

Prepared by:  
*Mary M. Ngabit*  
Forester, ICBFM desk Officer  
March 13, 2023

Approved by:  
*Jollinie*  
ENGR. CAESAR E. QUEBEC  
CENR Officer  
March 15, 2023

Copyright 2023

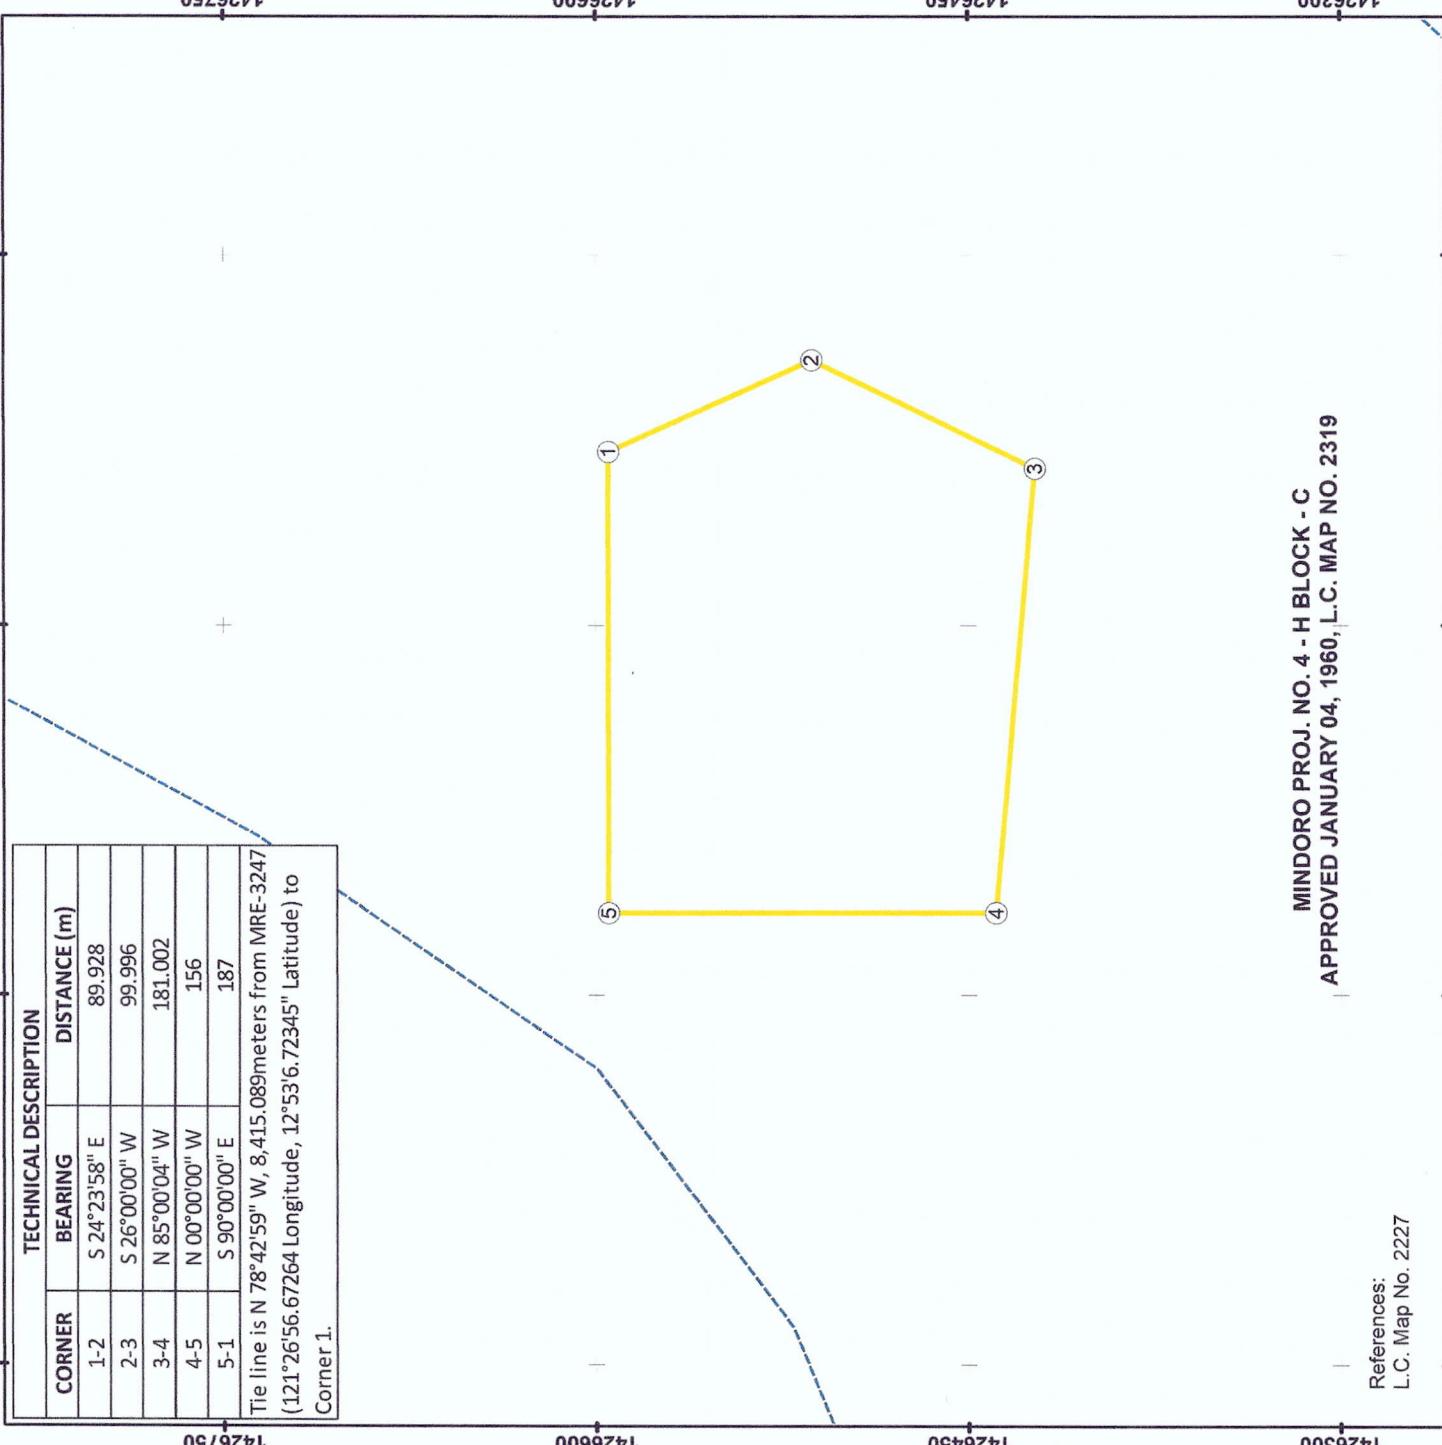

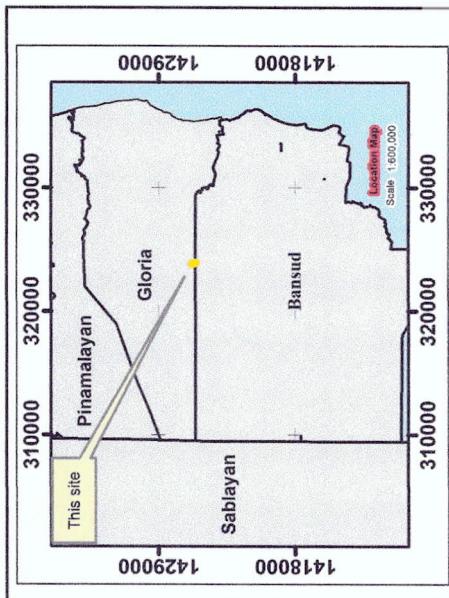

**CERTIFICATE OF STEWARDSHIP CONTRACT  
(CSC) NO. 028556  
OF**

**VIVCENTE RONCALI**

LOCATION: Barangay : Manguyang  
Municipality : Gloria  
Province : Oriental Mindoro

Total Area : 2.75 Hectares

Scale 1:3,000  
0 240 480 720 960 1200  
Metres  
Spheroid..... Clarke 1885  
Projection..... Universal Transverse Mercator (Zone 51)  
Horizontal Datum..... WGS 1984

**LEGEND**

- CSC Corner
- CSC Area
- Municipal Boundary
- Rivers and creeks

NOTE: The political boundaries are not authoritative.

Republic of the Philippines  
Department of Environment and Natural Resources  
MINAROPA Region  
Community Environment and Natural Resources Office  
San Mariano, Roxas, Oriental Mindoro


**CERTIFICATION**


This is to certify that this is the true and correct map of the areas under  
CERTIFICATE OF STEWARDSHIP CONTRACT (CSC) No. 028556 of  
Vivcente Roncali as described herein.  
This map was prepared based on the submitted maps, documents and  
other references available from this office.

MARCELENE M. NGABIT  
Forester/CBFM desk Officer  
March 13, 2023

CESAR E. QUEBEC  
ENGR/CENR Officer  
March 15, 2023

Approved by:  
Copyright 2023

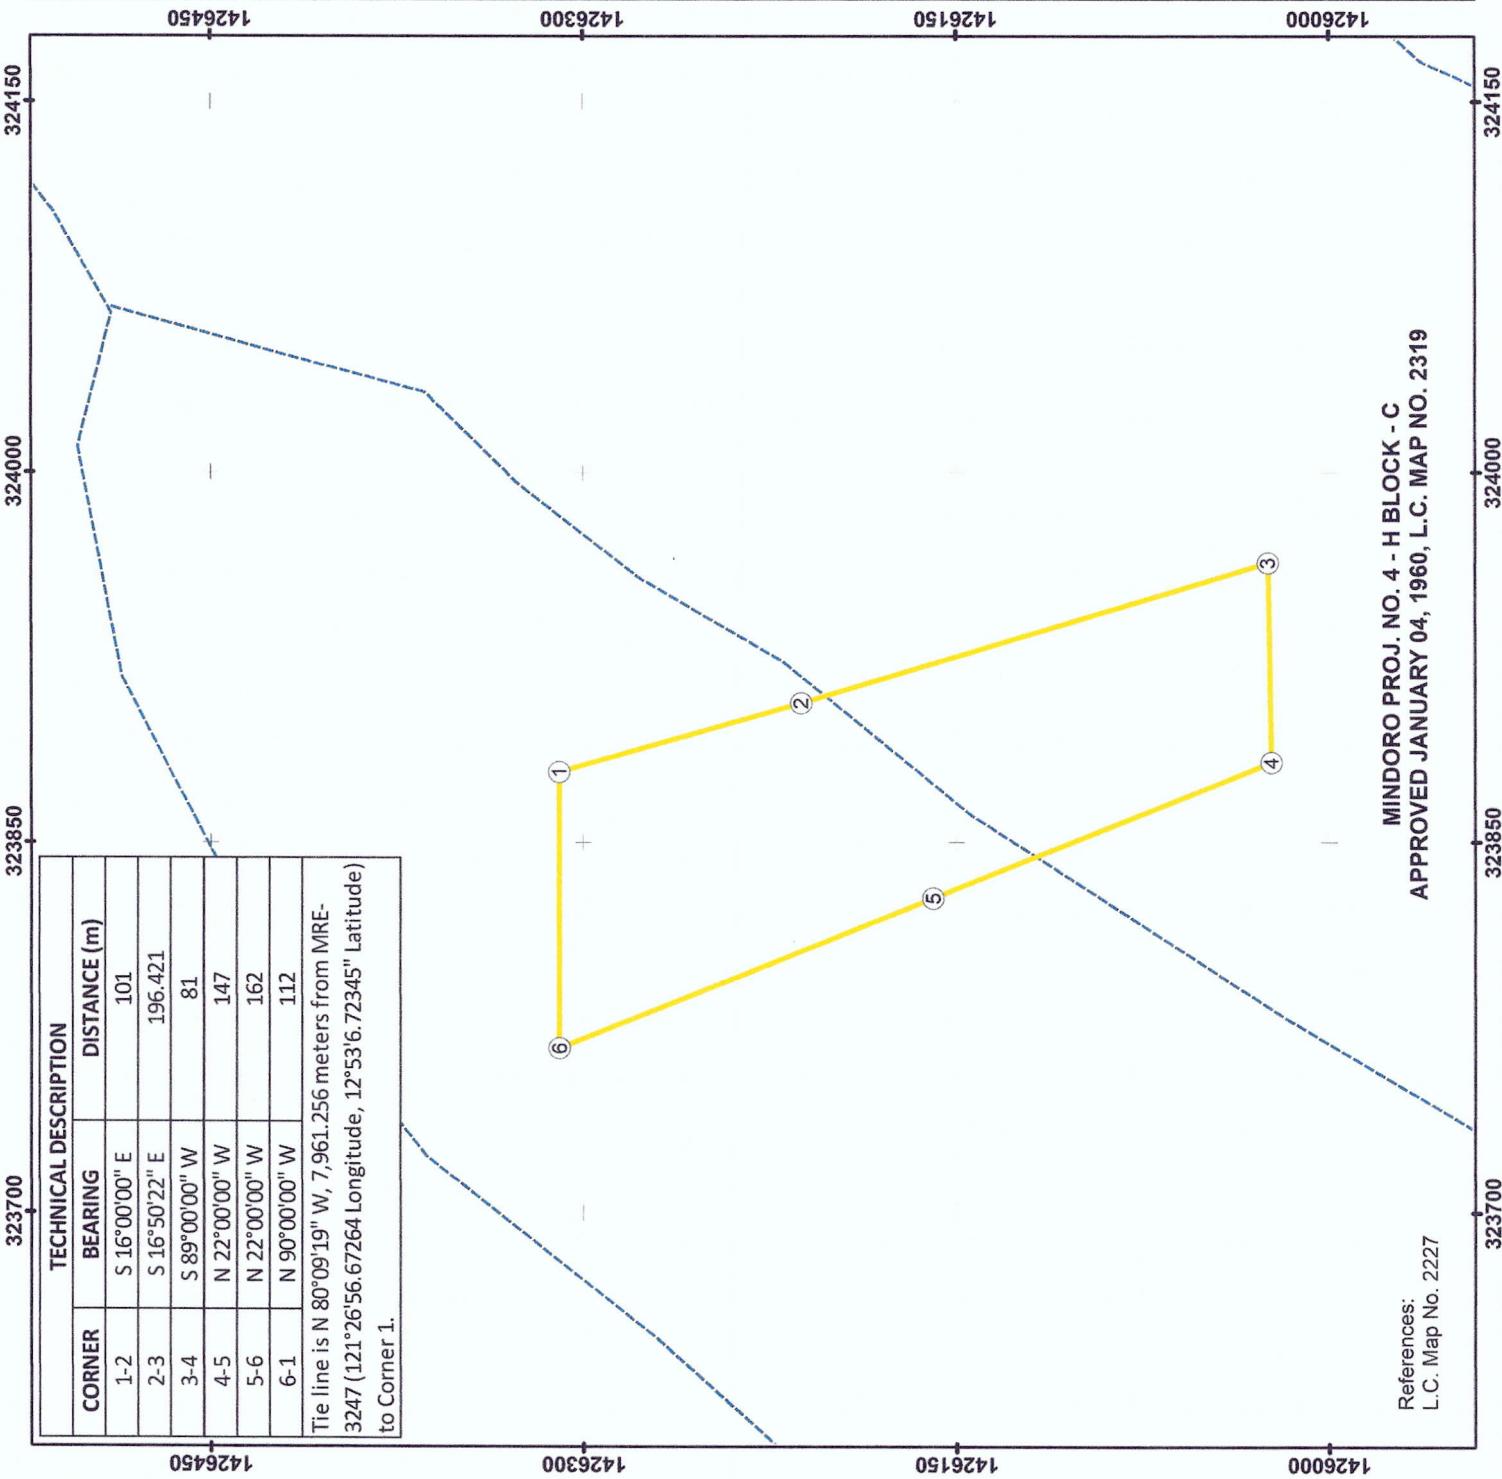

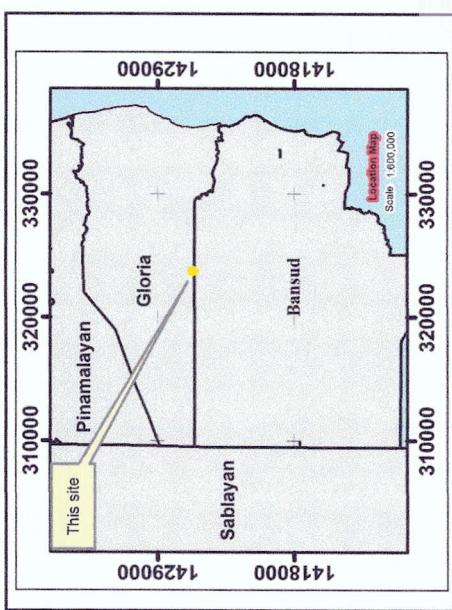

**CERTIFICATE OF STEWARDSHIP CONTRACT  
( CSC ) NO. 028555  
OF**

**ANGEL RONKALI**

LOCATION: Barangay : Manguyang  
Municipality : Gloria  
Province : Oriental Mindoro

Total Area : 3.46 Hectares

Scale 1:3,000  
0 1,000 2,000 3,000 4,000  
Metres  
Spheroid.....Clarke 1866  
Projection.....Universal Transverse Mercator (Zone 51)  
Horizontal Datum.....WGS 1984

**LEGEND**

- CSC Corner
- CSC Area
- Rivers and creeks
- Municipal Boundary

NOTE: The political boundaries are not authoritative.



**CERTIFICATION**

This is to certify that this is the true and correct map of the areas under Angel Ronkali as described herein.  
This map was prepared based on the submitted maps, documents and other references available from this office.

Prepared by:


**MARIO M. NGABIT**  
Forester / CBFM desk Officer  
March 13, 2023


**MINDORO PROJ. NO. 4 - H BLOCK - C**

**APPROVED JANUARY 04, 1960, L.C. MAP NO. 2319**

Approved by:

**ENGR. CESARIO E. QUEBEC**  
CENR Officer  
March 15, 2023

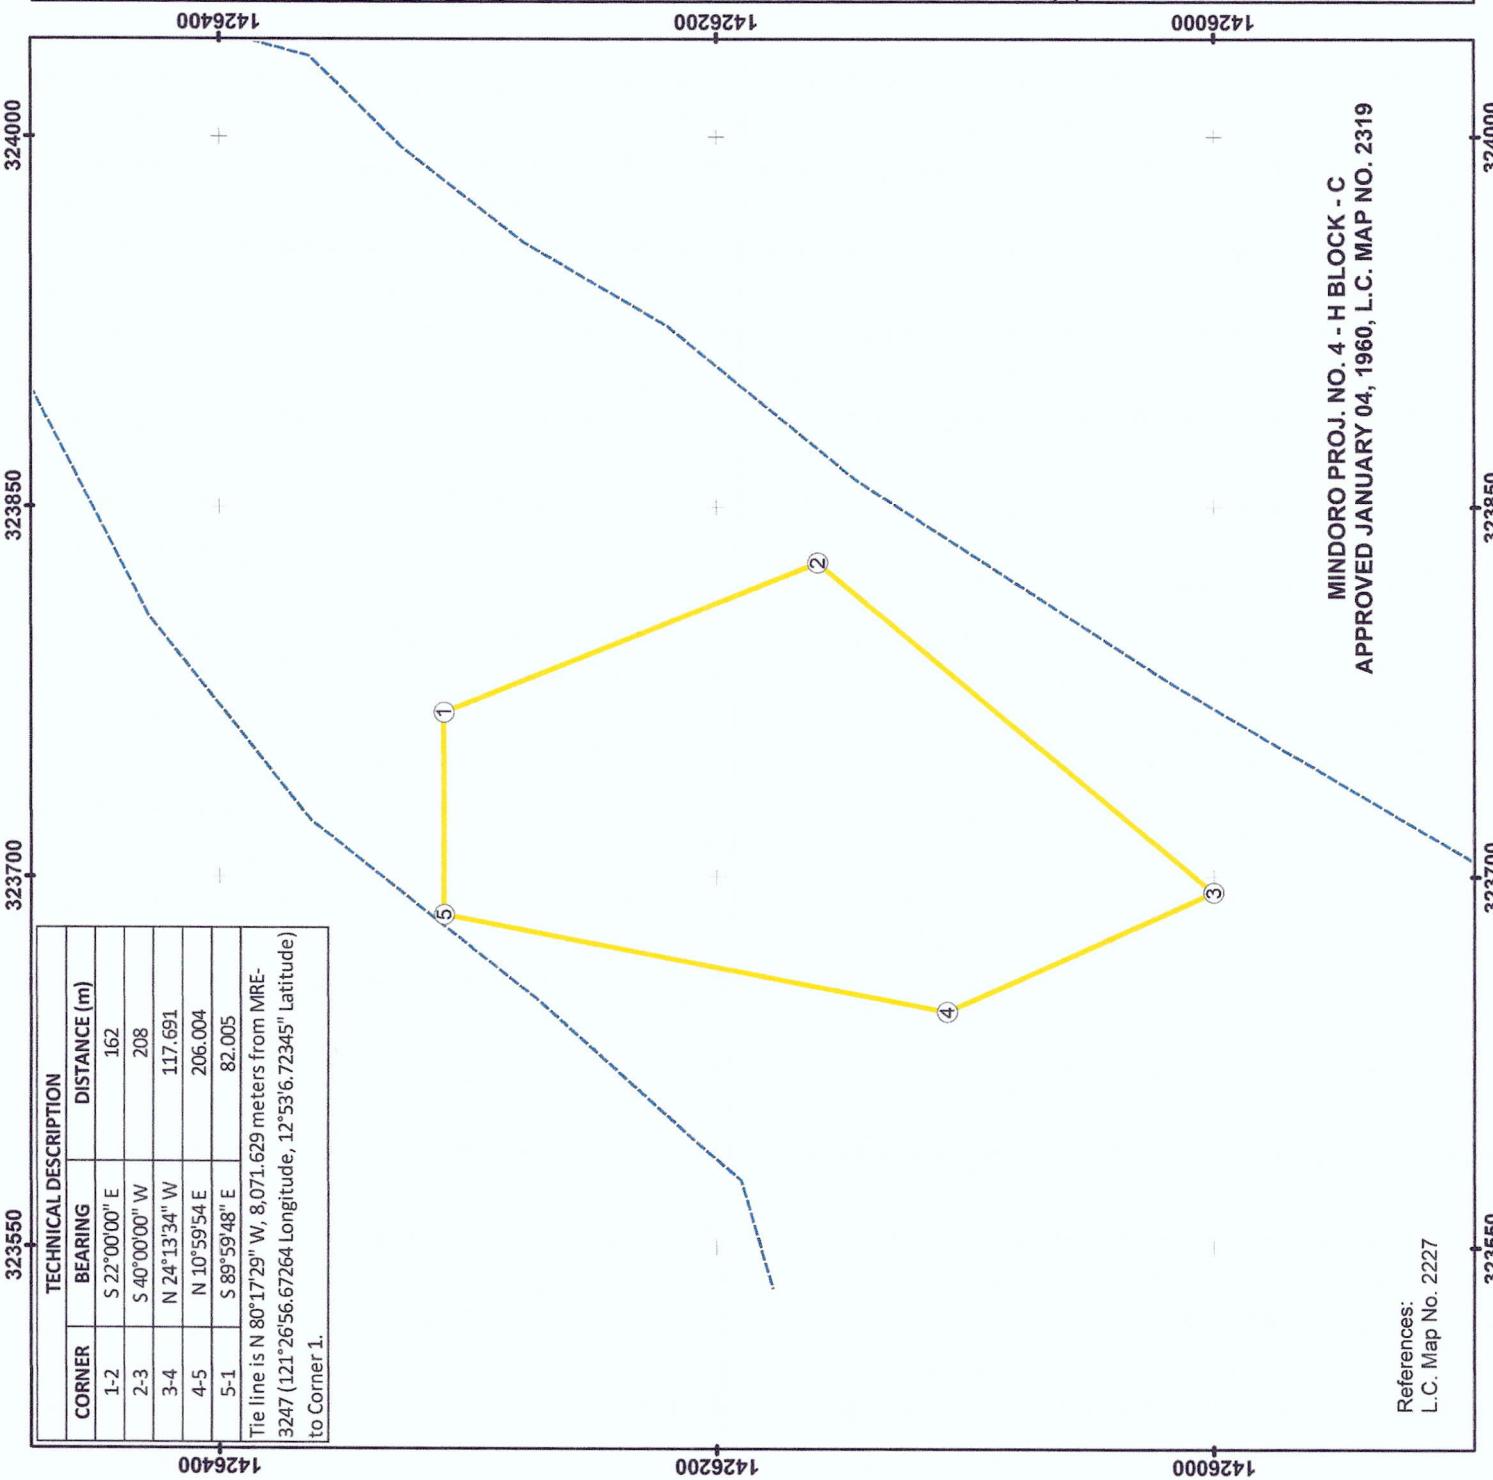

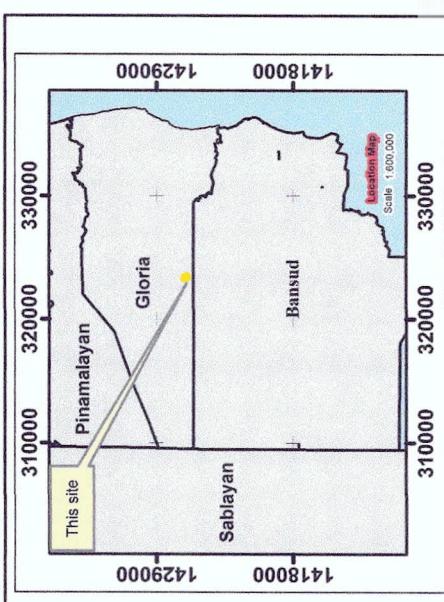

**CERTIFICATE OF STEWARDSHIP CONTRACT  
( CSC ) NO. 028546**

BELEN SALVA

**LOCATION:** Barangay : Manguyang  
Municipality : Gloria  
Province : Oriental Mindoro

Total Area : 256 Hectares

Socia 1:3 000

10,500

Spheroid: Clarke 1866  
Projection: Universal Transverse Mercator (Zone 51)  
Horizontal Datum: WGS 1984

| LEGEND             |  |
|--------------------|--|
| CSC Corner         |  |
| CSC Area           |  |
| Rivers and creeks  |  |
| Municipal Boundary |  |

**NOTE:** The political boundaries are not authoritative





CERTIFICATION

This is to certify that this is the true and correct map of the areas under  
This map was prepared based on the submitted maps, documents and  

MINDORO PROJ. NO. 4 - H BLOCK - C  
APPROVED JANUARY 04, 1960, L.C. MAP NO. 2319  
1426450

References:  
L.C. Map No. 2227

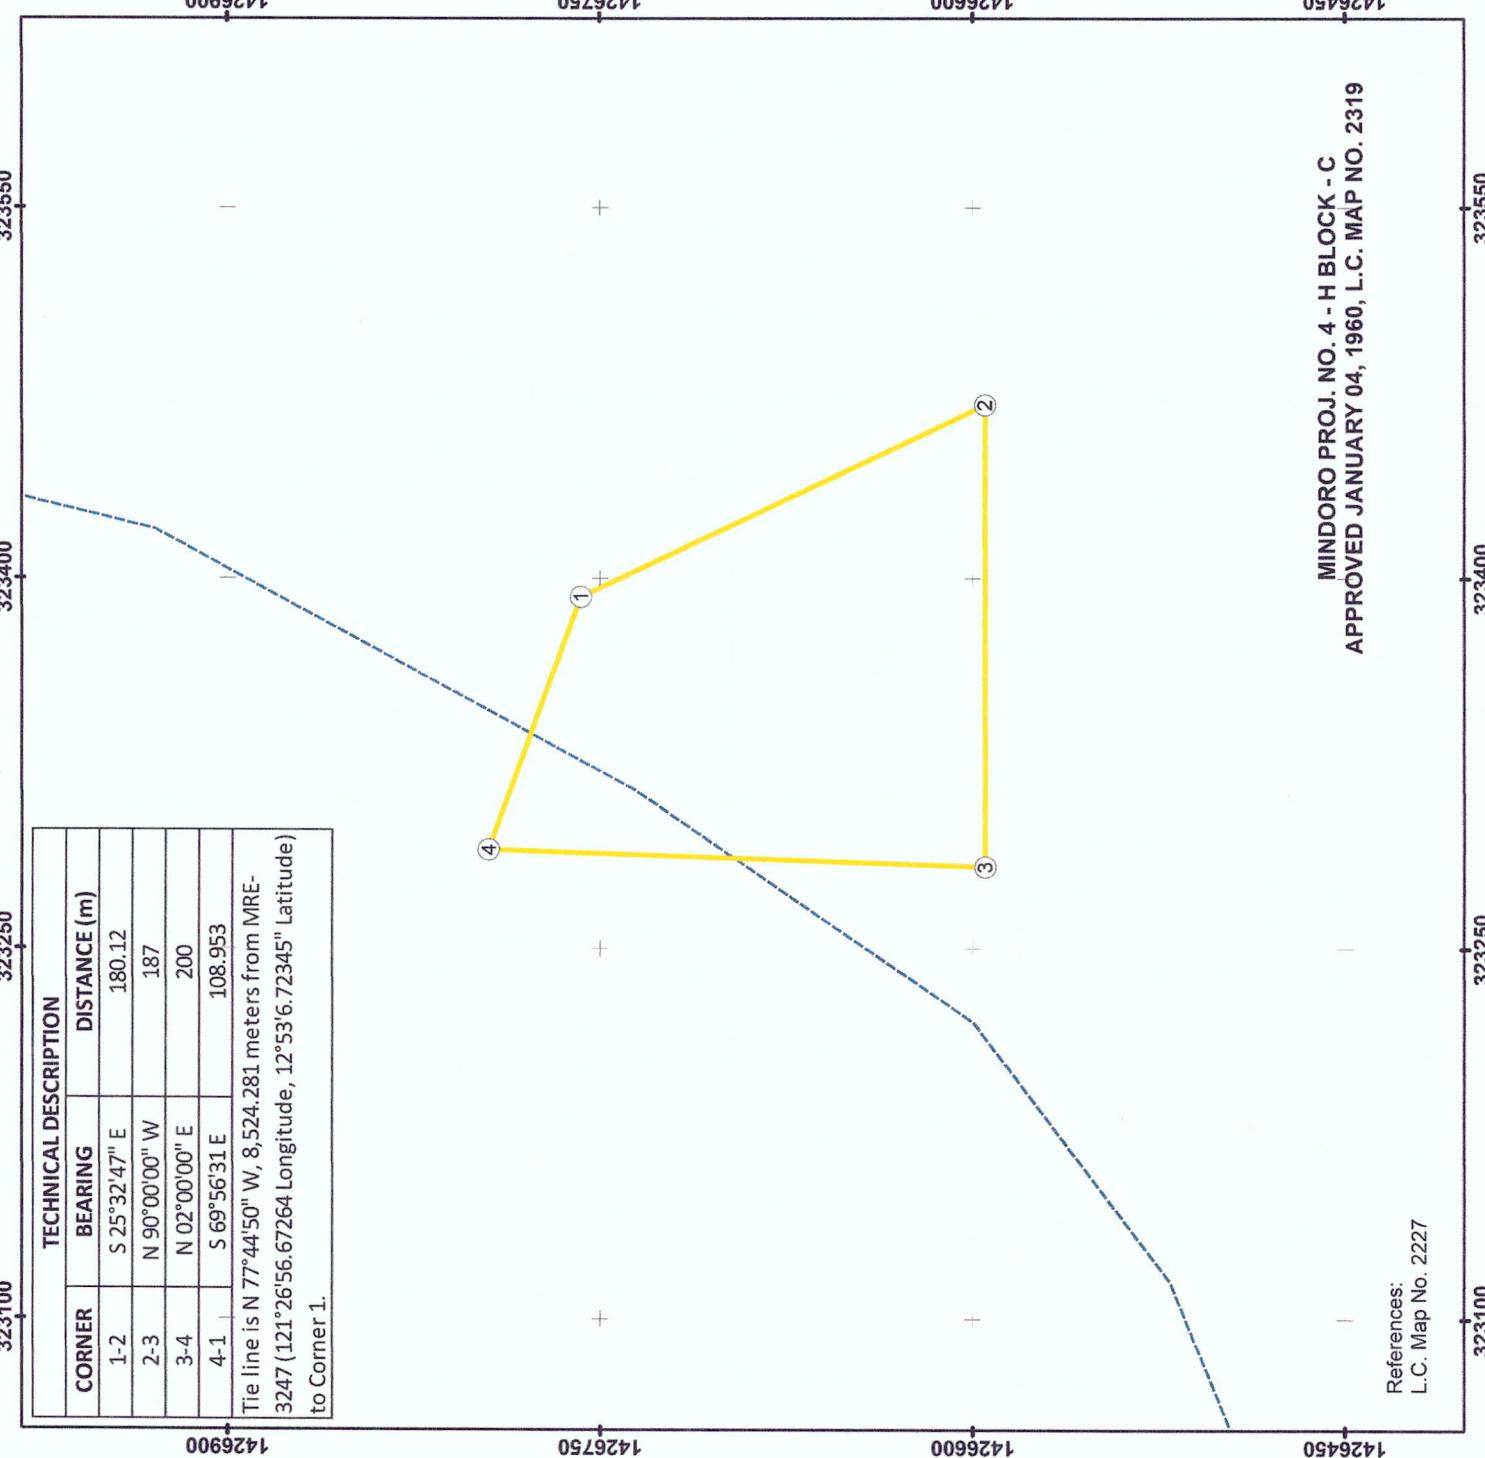

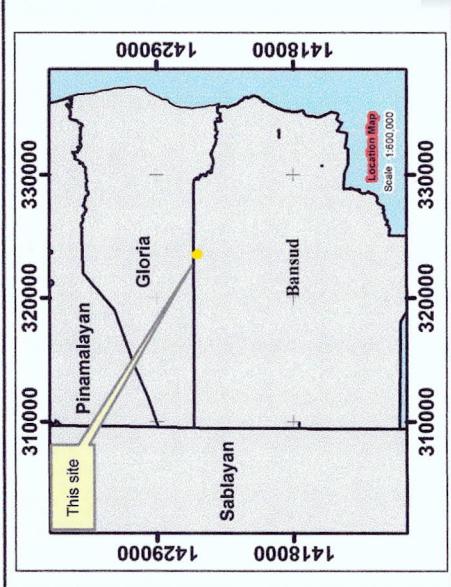

**CERTIFICATE OF STEWARDSHIP CONTRACT  
(CSC) NO. 028566  
OF**

**PELAGIO MAGGSINO**

**LOCATION:** Barangay : Contrazon  
Municipality : Bansud  
Province : Oriental Mindoro

**Total Area :** 2.69 Hectares

Scale 1:3,000  
Metres  
Projection..... Clarke 1886  
Universal Transverse Mercator (Zone 51)  
Horizontal Datum..... WGS 1984

**LEGEND**

- CSC Corner
- CSC Area
- Rivers and Creeks
- Municipal Boundary

NOTE: The political boundaries are not authoritative



**CERTIFICATION**


This is to certify that this is the true and correct map of the areas under CERTIFICATE OF STEWARDSHIP CONTRACT (CSC) No. 028566 of Pelagio Maggsino as described herein.  
This map was prepared based on the submitted maps, documents and other references available from this office.


+ **MINDORO PROJ. NO. 4 - H BLOCK - C**  
**APPROVED JANUARY 04, 1960, L.C. MAP NO. 2319**

Prepared by:  
*[Signature]* MARIBEL M. NGABIT  
Forester/ICBM Desk Officer  
March 13, 2023


Approved by:  
*[Signature]* ENGR. CAESAR E. OUEBEC  
ENR Officer  
March 15, 2023

Copyright 2023

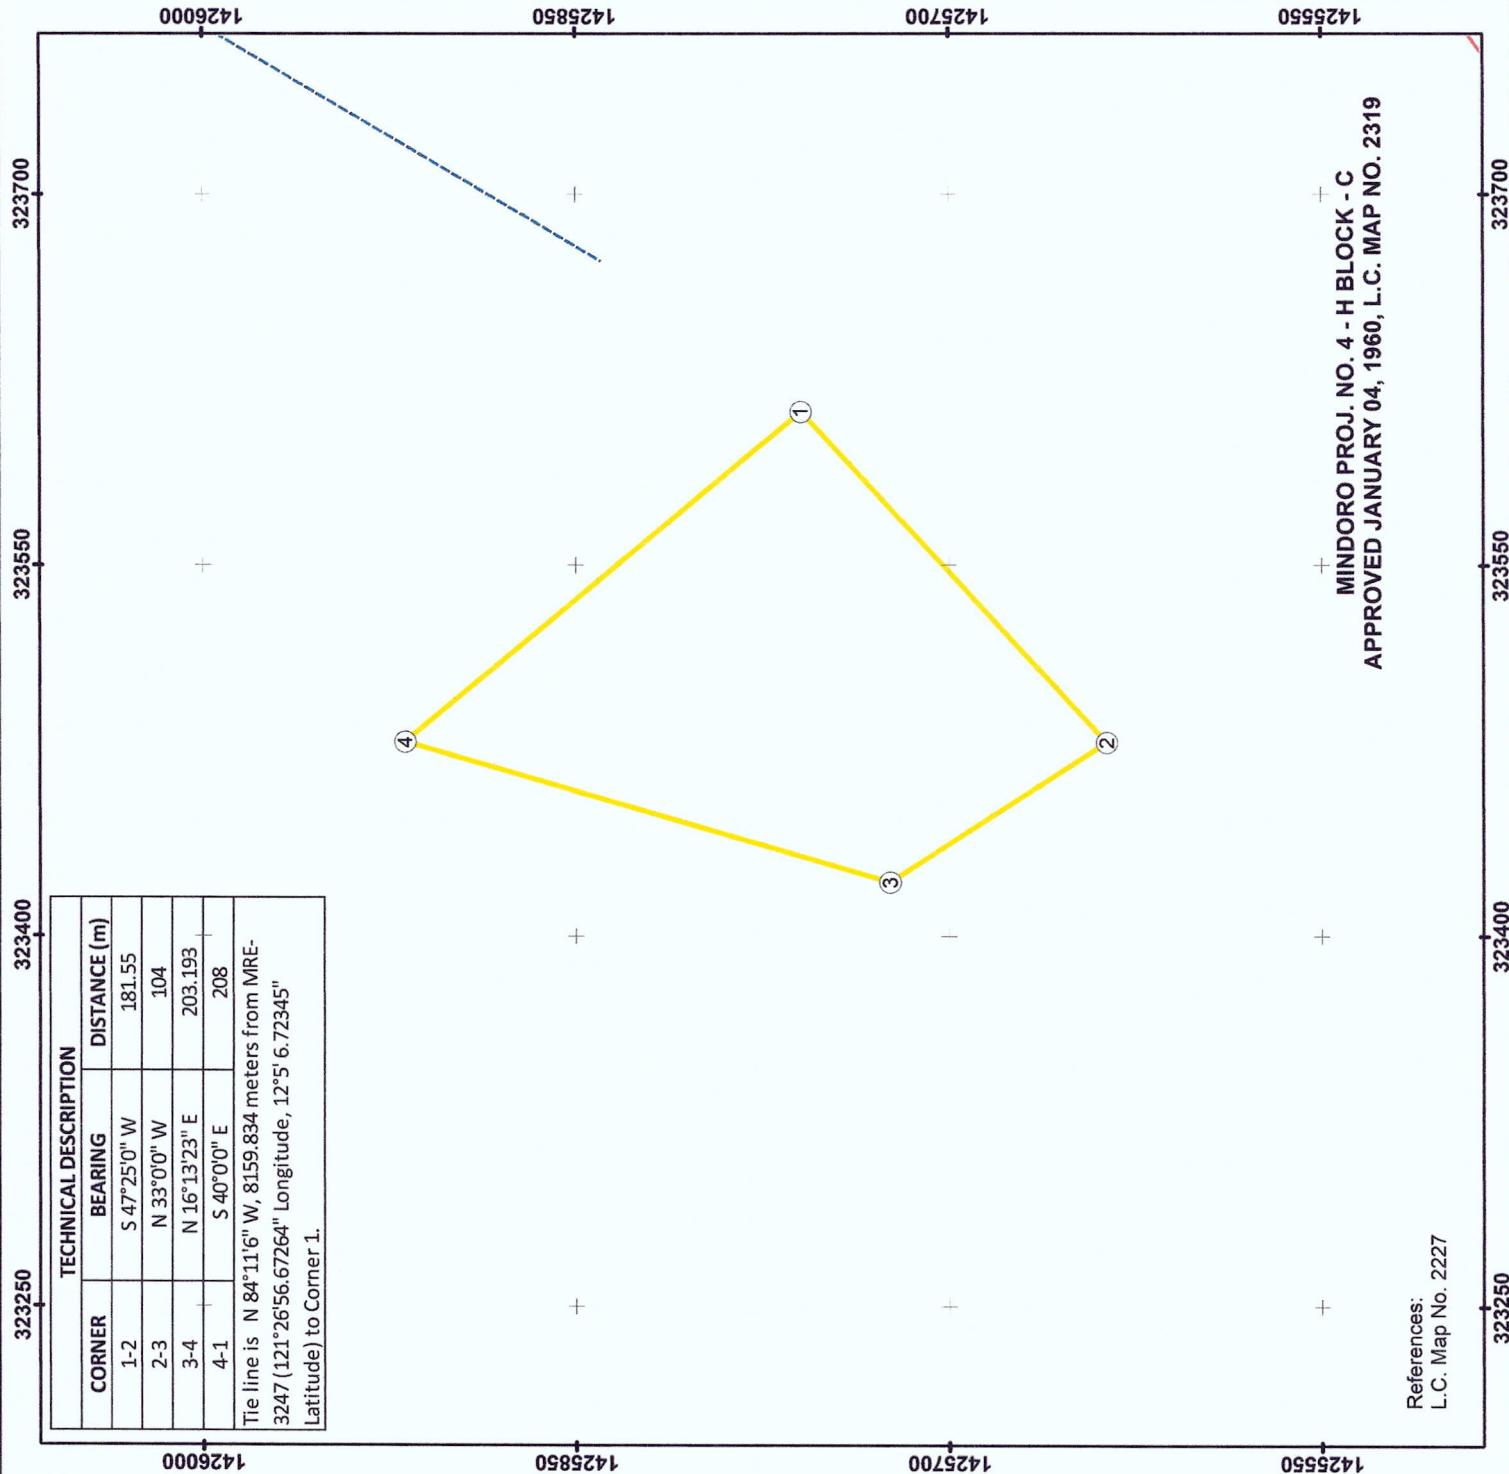

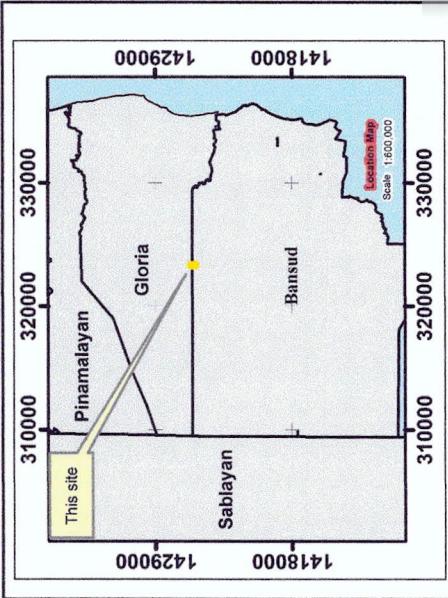

1426150 1426000 1425850 1426150

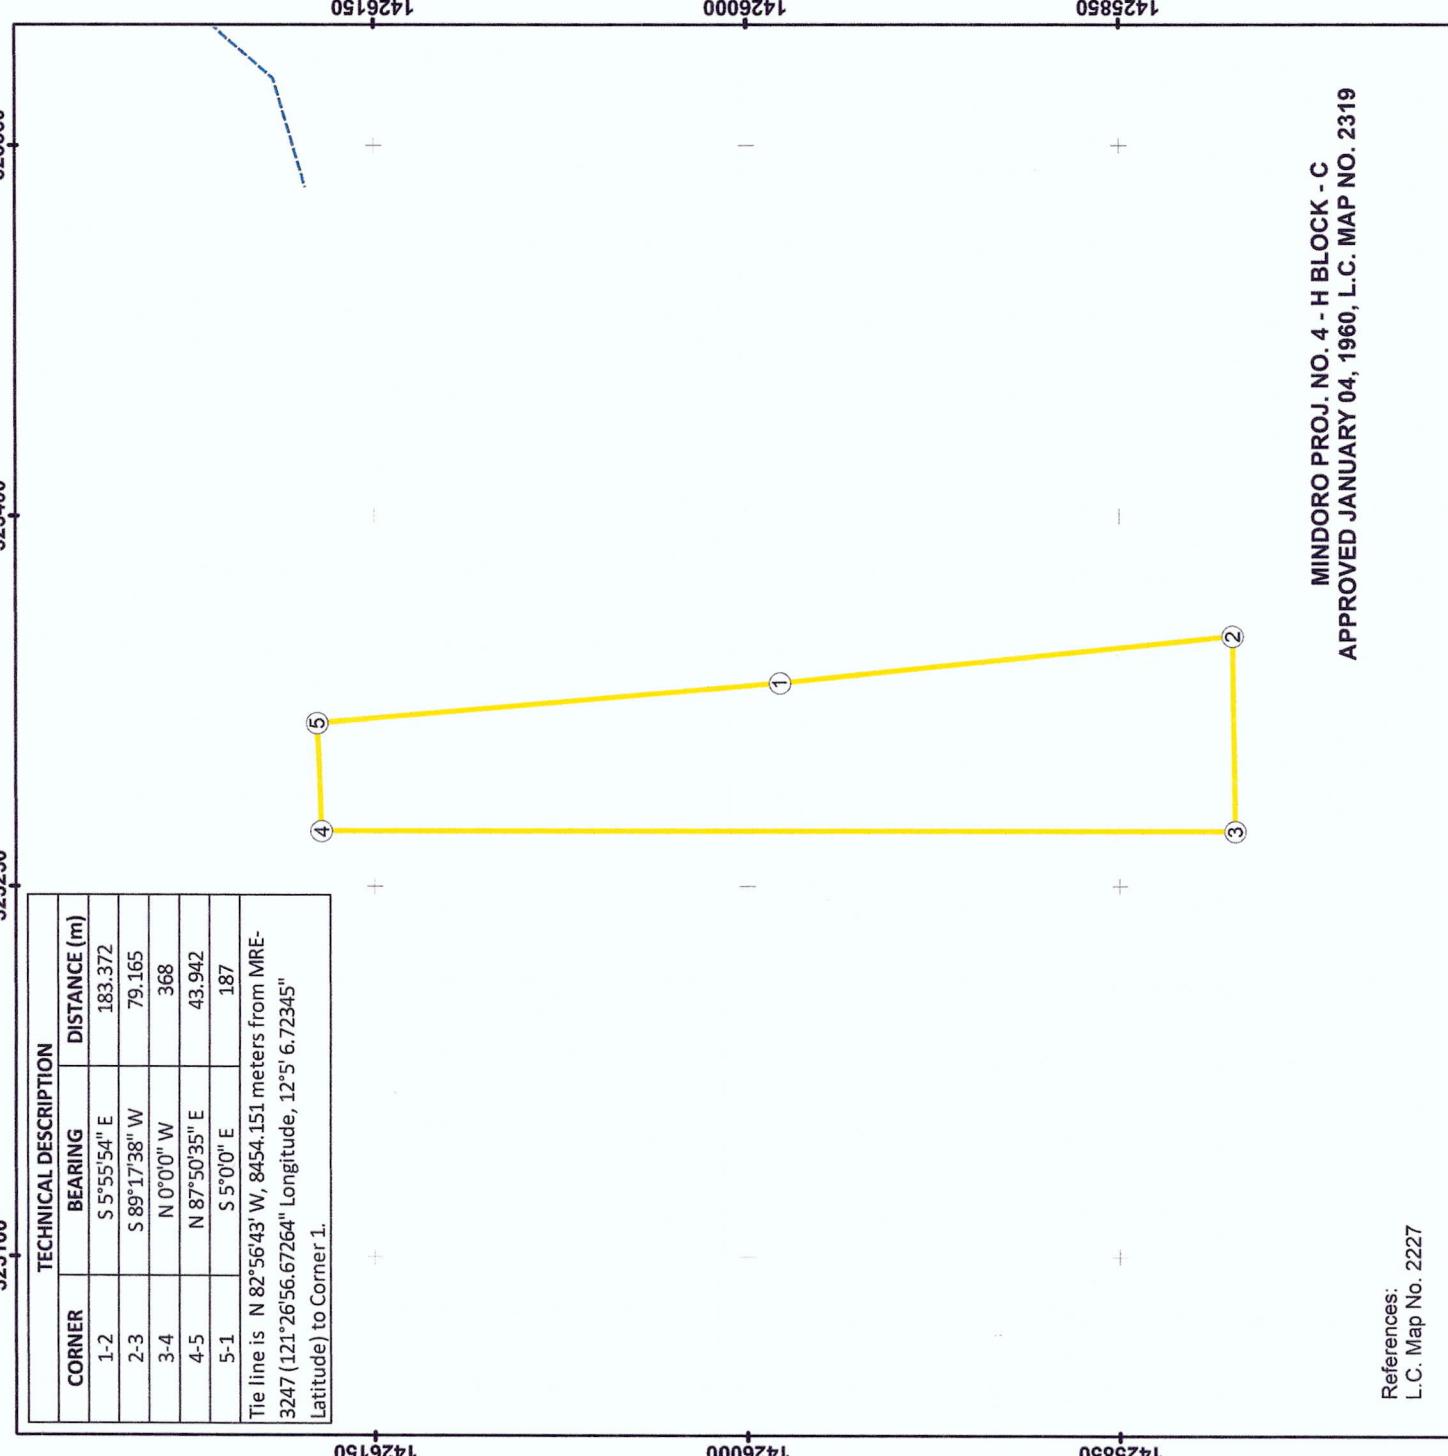

CERTIFICATE OF STEWARDSHIP CONTRACT  
(CSC) NO. 028564

OF  
**PONCIANO VERA**

LOCATION: Barangay : Contrazon  
Municipality : Bansud  
Province : Oriental Mindoro


Total Area : 2.24 Hectares

Scale 1:3,000  
0 2,625 5,250 10,500 15,750 21,000  
Metres  
Spheroid.....Clarke 1866  
Projection.....Universal Transverse Mercator (Zone 51)  
Horizontal Datum.....NGS 1984

LEGEND

- CSC Corner
- CSC Area
- Rivers and Creeks
- Municipal Boundary

NOTE: The political boundaries are not authoritative

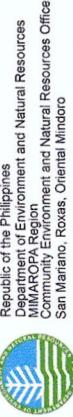

CERTIFICATION

This is to certify that this is the true and correct map of the areas under CERTIFICATE OF STEWARDSHIP CONTRACT (CSC) No. 028564 of Ponciano Vera as described herein.  
This map was prepared based on the submitted maps, documents and other references available from this office.

Prepared by:

MARCELLIN NGABIT  
Forester/CBM Desk Officer

MINDORO PROJ. NO. 4 - H BLOCK - C  
APPROVED JANUARY 04, 1960, L.C. MAP NO. 2319

References:  
L.C. Map No. 2227


323550

CESARE QUEZEC  
CENR Officer

Approved by:

March 13, 2023

March 15, 2023

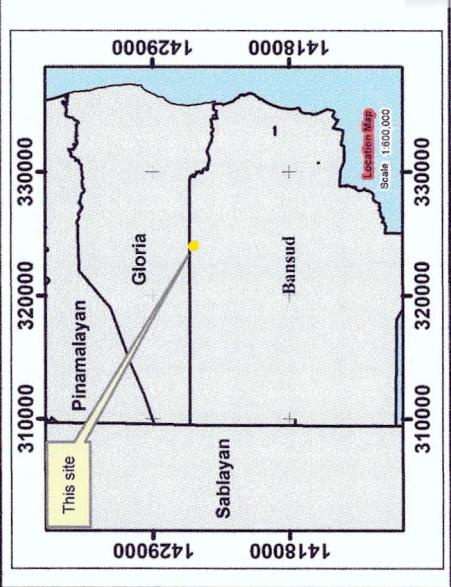

**CERTIFICATE OF STEWARDSHIP CONTRACT  
(CSC) NO. 028586  
OF**

**PEDRO MASO**

LOCATION: Barangay : Contrazon  
Municipality : Bansud  
Province : Oriental Mindoro  
  
Total Area : 3.38 Hectares

Scale 1:3,000  
0 2,500 5,000 10,000 15,000 20,000  
Meters  
Spheroid.....Clarke 1866  
Projection.....Universal Transverse Mercator (Zone 51)  
Horizontal Datum.....WGS 1984

**LEGEND**  
CSC Corner (Yellow Circle) CSC Area (Yellow Box) Rivers and Creeks (Blue Line)  
CADD123 Boundary (Red Line) Municipal Boundary (Blue Line)

NOTE: The political boundaries are not authoritative.  
Republic of the Philippines  
Department of Environment and Natural Resources  
San Matano, Roxas, Oriental Mindoro

**CERTIFICATION**

This is to certify that this is the true and correct map of the areas under  
CERTIFICATE OF STEWARDSHIP CONTRACT (CSC) No. 028586 of  
Pedro Maso as described hereon.  
This map was prepared based on the submitted maps, documents and  
other references available from this office.

Approved by:

*[Signature]*  
MARIE L. MANGABIT  
Forester/CBFM Desk Officer


March 13, 2023


*[Signature]*  
ENGR. CAESAR E. QUEZON  
ENR Officer

March 15, 2023

Date

Copyright 2023

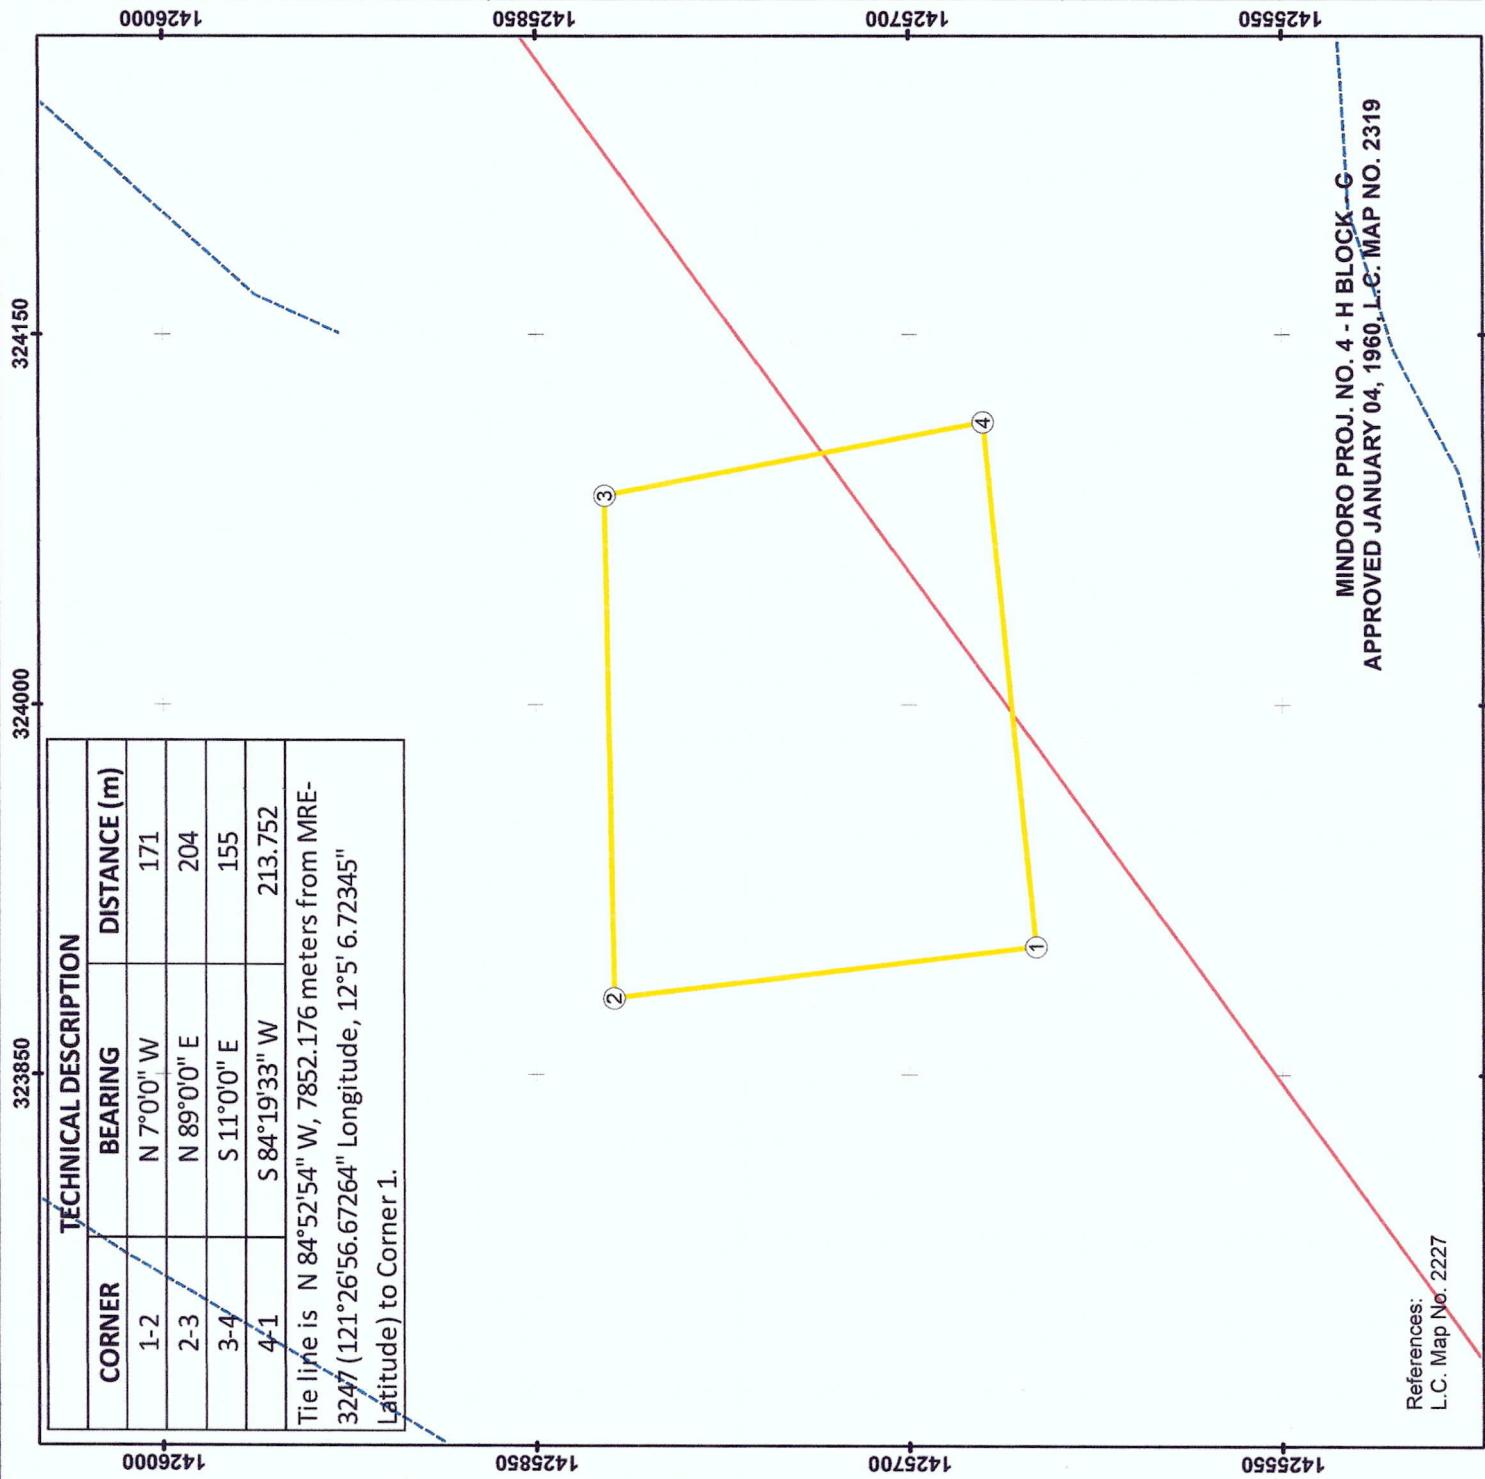

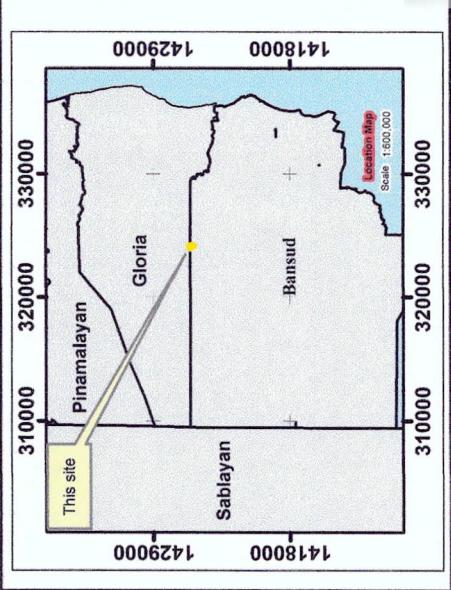

**CERTIFICATE OF STEWARDSHIP CONTRACT  
(CSC) NO. 028559  
OF**

**PABLO MAGADIA**

LOCATION: Barangay : Contrazon  
Municipality : Bansud  
Province : Oriental Mindoro

Total Area : 2.14 Hectares

Scale 1:3,000  
0 2.50 5.00 7.50 10.00 12.50 15.00  
Meters  
Spheroid: Clarke 1866  
Projection: Universal Transverse Mercator (Zone 51)  
Horizontal Datum: WGS 1984

**LEGEND**

- CSC Corner
- CSC Area
- CAD123 Boundary
- Municipal Boundary

NOTE: The political boundaries are not authoritative.

Republic of the Philippines  
Department of Environment and Natural Resources  
Community Environment and Natural Resources Office  
San Matano, Roxas, Oriental Mindoro


**CERTIFICATION**


This is to certify that this is the true and correct map of the areas under  
CERTIFICATE OF STEWARDSHIP CONTRACT (CSC) No. 028559 of  
Pablo Magadia as described herein.  
This map was prepared based on the submitted maps, documents and  
other references available from this office.

1425700

MINDORO PROJ. NO. 4 - H BLOCK - C  
APPROVED JANUARY 04, 1960, L.C. MAP NO. 2319

Date: March 13, 2023  
Date: March 15, 2023  
Date: Copyright 2023

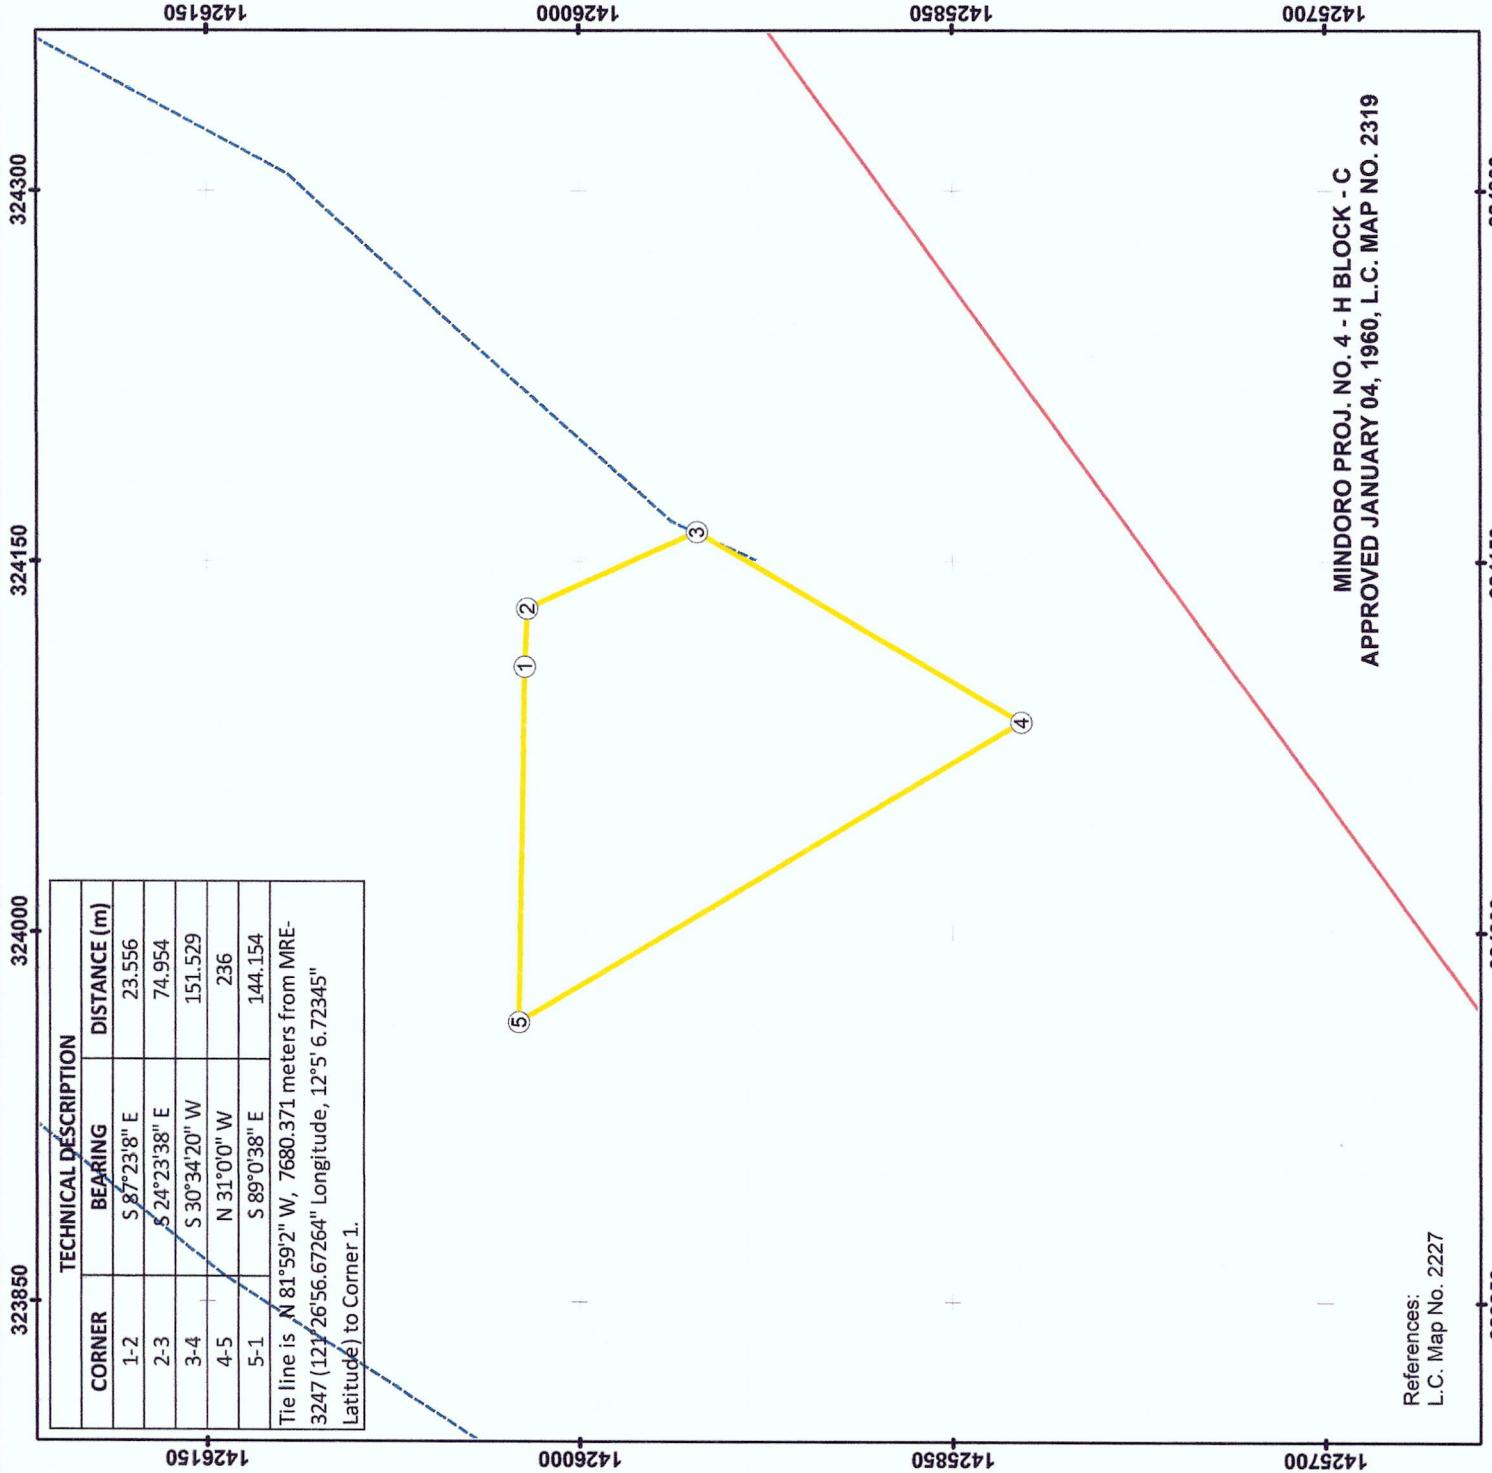

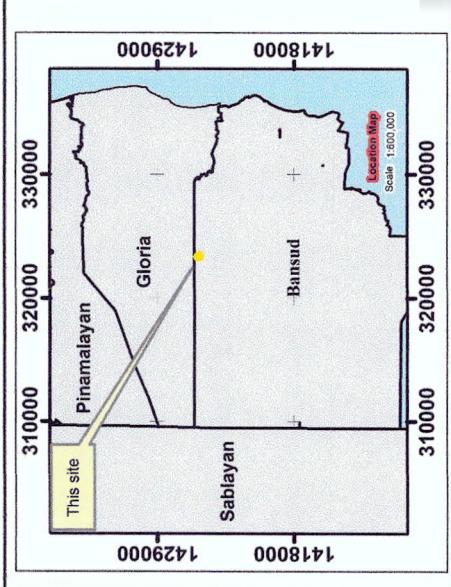

CERTIFICATE OF STEWARDSHIP CONTRACT  
(CSC) NO. 028571  
OF

**NELSON PALMA**

LOCATION: Barangay : Contrazon  
Municipality : Bansud  
Province : Oriental Mindoro

Total Area : 2.47 Hectares

Scale 1:3,000  
0 2430 6210 10,000 15,750 21,500  
Metres  
Spheroid.....Clarke 1886  
Projection.....Universal Transverse Mercator (Zone 51)  
Horizontal Datum.....WGS 1984

LEGEND

- CSC Corner
- CSC Area
- Municipal Boundary

NOTE: The political boundaries are not authoritative



Republic of the Philippines  
Department of Environment and Natural Resources

MIMAROPA Region  
Community Environment and Natural Resources Office

San Mariano, Roxas, Oriental Mindoro

CERTIFICATION

This is to certify that this is the true and correct map of the areas under CERTIFICATE OF STEWARDSHIP CONTRACT (CSC) No. 028571 of Nelson Palma as described herein.

This map was prepared based on the submitted maps, documents and other references available from this office.

Prepared by:

*[Signature]*  
MARIELEN M. NGABIT  
Forester/FCBFM Desk Officer

Approved by:

*[Signature]*  
CESARE E. QUESEC  
ENGR. CENR Officer

March 13, 2023


March 15, 2023

MINDORO PROJ. NO. 4 - H BLOCK - C  
APPROVED JANUARY 04, 1960, L.C. MAP NO. 2319


Copyright 2023

| TECHNICAL DESCRIPTION |                 |              |
|-----------------------|-----------------|--------------|
| CORNER                | BEARING         | DISTANCE (m) |
| 1-2                   | S 33° 0' 0" E   | 104          |
| 2-3                   | S 90° 0' 0" W   | 206          |
| 3-4                   | N 0° 0' 0" E    | 167          |
| 4-5                   | N 89° 17' 38" E | 79.165       |
| 5-1                   | S 41° 0' 0" E   | 107          |

Tie line is N 84° 39' 54" W, 8337.114 meters from MRE-3247 (121° 26' 56.67264" Longitude, 12° 5' 6.72345" Latitude) to Corner 1.

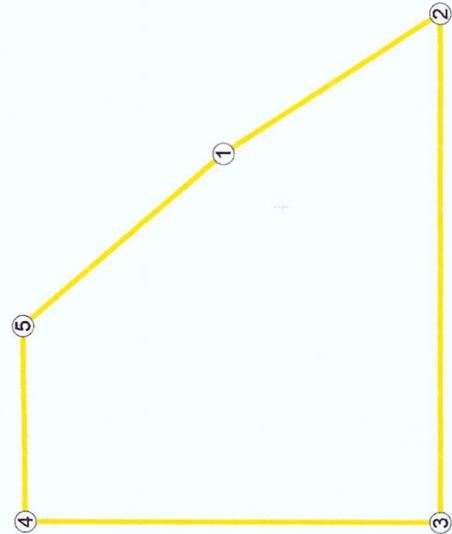

References:  
L.C. Map No. 2227

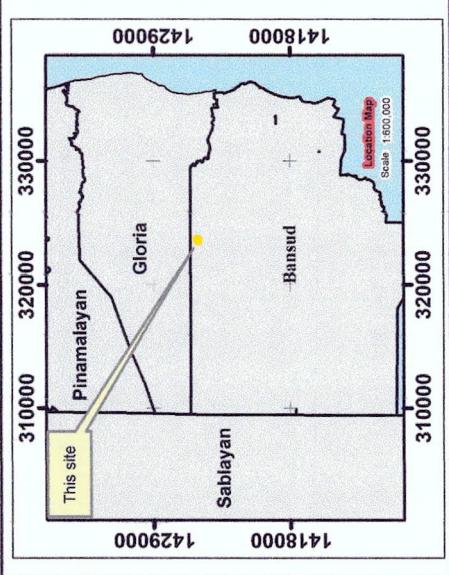

**CERTIFICATE OF STEWARDSHIP CONTRACT**  
(CSC) NO. 028574  
OF

**LOPE DAVIS**

LOCATION: Barangay : Contrazon  
Municipality : Bansud  
Province : Oriental Mindoro  
Total Area : 1.92 Hectares

Scale 1:3,000  
0 2.25 5.50 10.00 15.750 21.000  
Metres  
Spheroid.....Clarke 1866  
Projection.....Universal Transverse Mercator (Zone 51)  
Horizontal Datum.....NGS 1844

**LEGEND**

- CSC Corner
- CSC Area
- CADC123 Boundary
- Rivers and Creeks
- Municipal Boundary

NOTE: The political boundaries are not authoritative.



Republic of the Philippines  
Department of Environment and Natural Resources  
Region IV-A  
Compliance Monitoring and Natural Resources Office

San Matano, Roxas, Oriental Mindoro

Copyright 2023

**CERTIFICATION**  
This is to certify that this is the true and correct map of the areas under  
CERTIFICATE OF STEWARDSHIP CONTRACT (CSC) No. 028574 of  
Lope Davis as described hereon.  
This map was prepared based on the submitted maps, documents and  
other references available from this office.

Prepared by:  
*MARIELE M. NGABIT*  
Forester/CBFM Desk Officer  
March 13, 2023

Approved by:  
*ENGR. CAESAR E. QUEBEC*  
ENR Officer  
March 15, 2023

Date  
Copyright 2023


**MINDORO PROJ. NO. 4 - H BLOCK - C**  
**APPROVED JANUARY 04, 1960, L.C. MAP NO. 2319**

References:  
L.C. Map No. 2227

323400 323550 323700 323850  
+ + + +  
1425700 1425550 1425400 1425250  
+ + + +  
323400 323550 323700 323850  
+ + + +

| TECHNICAL DESCRIPTION |               |              |
|-----------------------|---------------|--------------|
| CORNER                | BEARING       | DISTANCE (m) |
| 1-2                   | N 45°0'0" E   | 139          |
| 2-3                   | N 69°0'0" E   | 126          |
| 3-4                   | S 1°0'0" E    | 143          |
| 4-1                   | S 89°52'42" W | 218.415      |

Tie line is N 86°46'45" W, 8295.579 meters from MRE-  
3247 (121°26'56.67264" Longitude, 12°5' 6.72345"  
Latitude) to Corner 1.

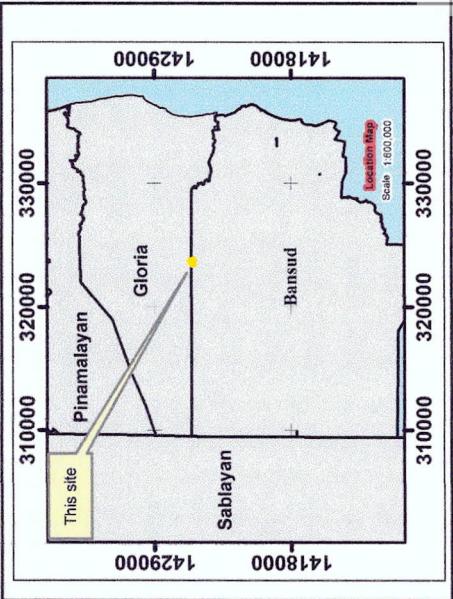

**CERTIFICATE OF STEWARDSHIP CONTRACT  
(CSC) NO. 028562**


**LOCATION:** Barangay : Conrazon  
Municipality : Bansud  
Province : Oriental Mindoro

Total Area : 248 Hectares

Scale 1:3,000

Spheroid.....Clarke 1866  
Projection.....Universal Transverse Mercator (Zone 51)  
Horizontal Datum.....WGS 1984  
Meters

## LEGEND

|                    |  |
|--------------------|--|
| CSC Corner         |  |
| CSC Area           |  |
| Rivers and Creeks  |  |
| Municipal Boundary |  |

**NOTE:** The political boundaries are not authoritative



## CERTIFICATION

the true and correct map of the areas under


CERTIFICATE OF STEWARDSHIP CONTRACT (CSC) NO. 025562 of  
Julian Iiao as described hereon.  
This map was prepared based on the submitted maps, documents and  
other references available from this office.


Prepared by:

APPROVED JANUARY 04, 1960, L.C. MAP NO. 2319


References:  
L.C. Map No. 2227

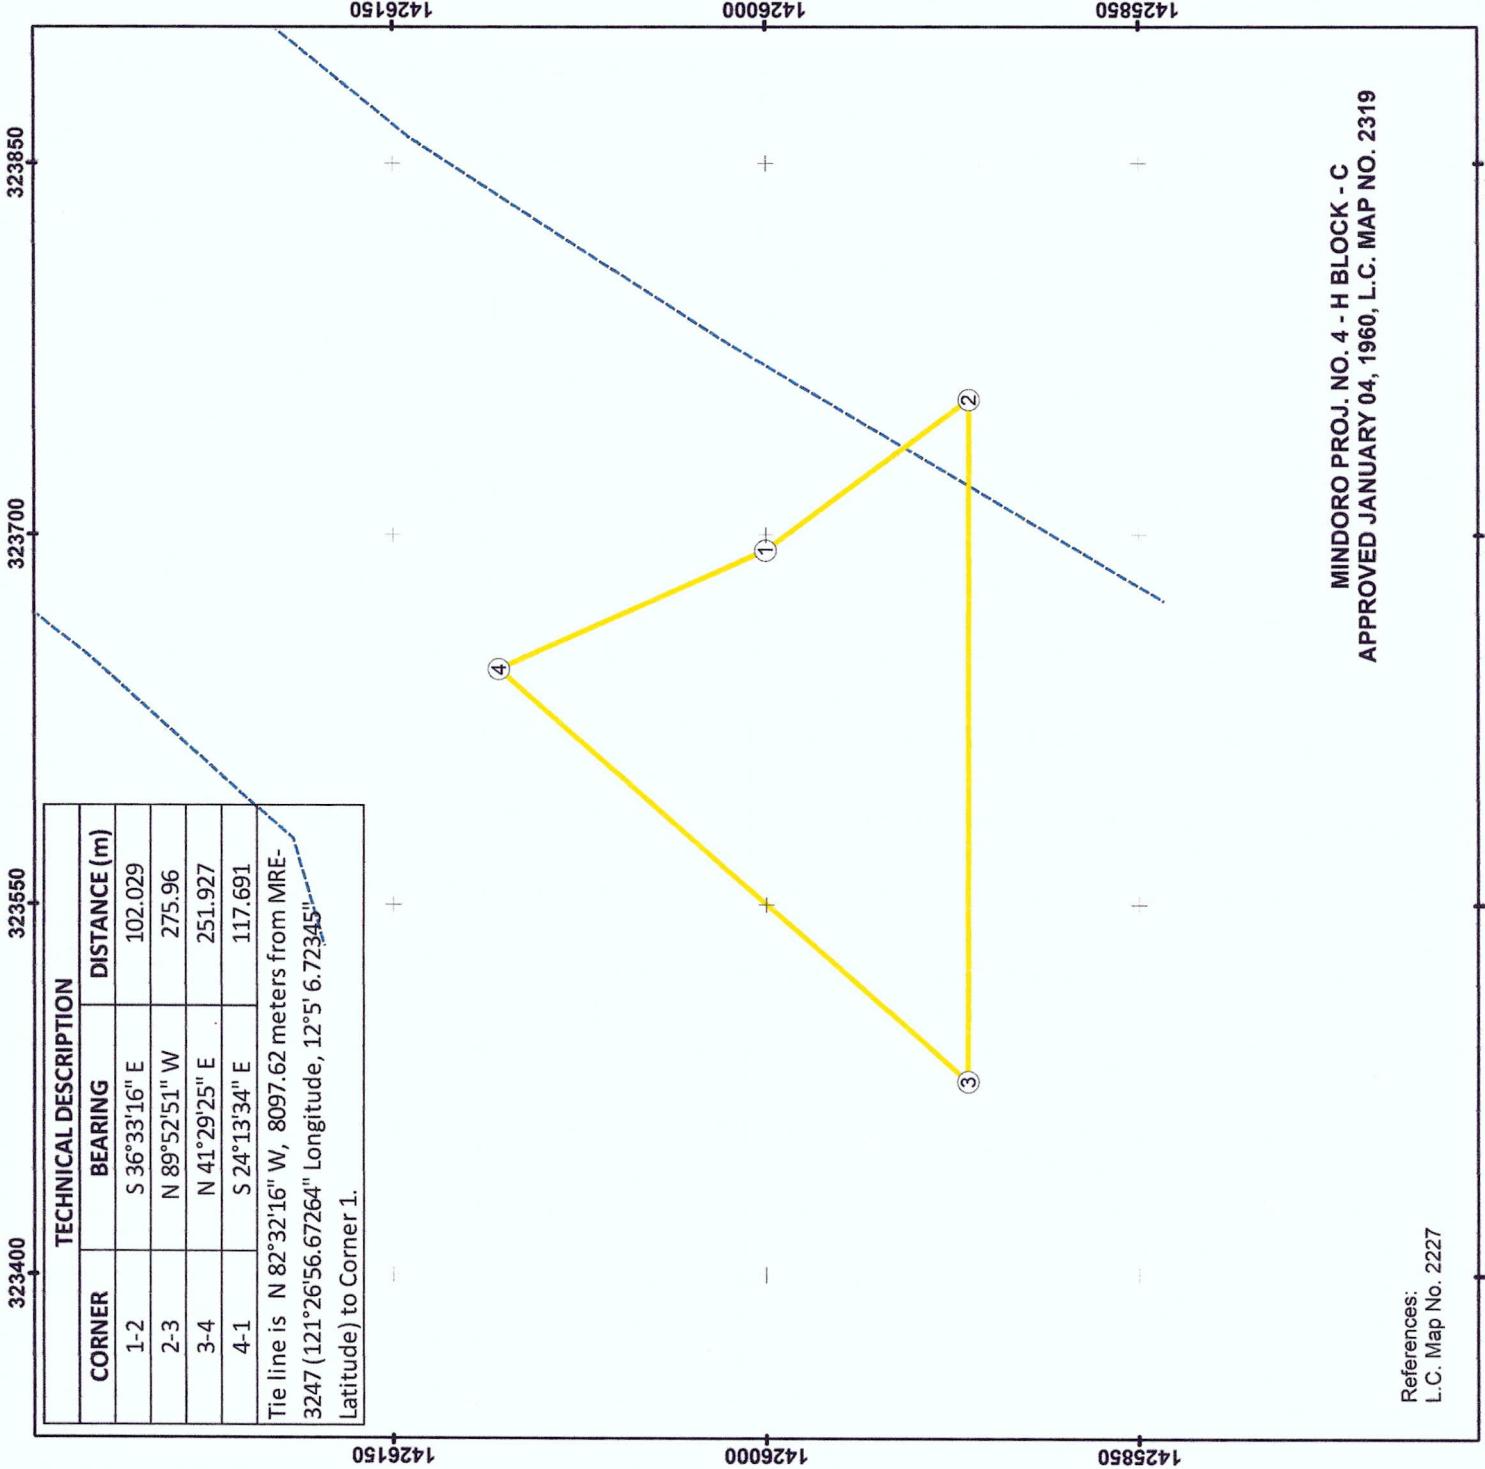

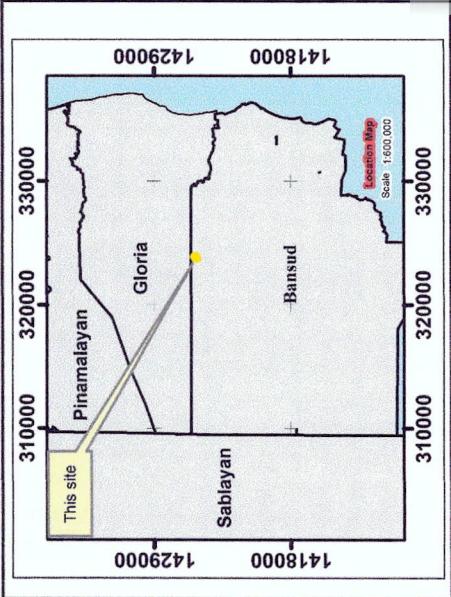

CERTIFICATE OF STEWARDSHIP CONTRACT  
(CSC) NO. 028569  
OF

**JOVITO RAVANO**

LOCATION: Barangay : Contrazon  
Municipality : Bansud  
Province : Oriental Mindoro

Total Area : 3.29 Hectares

Scale 1:3,000  
Spheroid.....Clarke 1866  
Projection.....Universal Transverse Mercator (Zone 51)  
Horizontal Datum.....NGS 1984

- LEGEND  
○ CSC Corner    — Rivers and Creeks  
■ CSC Area    □ Municipal Boundary  
■ CAD123 Boundary

NOTE: The political boundaries are not authoritative



Republic of the Philippines  
Department of Environment and Natural Resources  
Community Environment and Natural Resources Office  
San Mariano, Roxas, Oriental Mindoro

CERTIFICATION

This is to certify that this is the true and correct map of the areas under  
CERTIFICATE OF STEWARDSHIP CONTRACT (CSC) No. 028569 of  
Jovito Ravano as described herein.  
This map was prepared based on the submitted maps, documents and  
other references available from this office.

Prepared by:  
○ MARVEL M. NGABIT  
Foresi /CBFM Desk Officer      March 13, 2023  
■ ENGR. CESAR E. QUEBEC  
CENR Officer      March 15, 2023  
 Approved by:  
○ *Signature*      March 15, 2023  
■ *Signature*      Date  
 Copyright 2023


MINDORO PROJ NO.4 - H BLOCK - C  
APPROVED JANUARY 04, 1960, L.C. MAP NO. 2319

References:  
L.C. Map No. 2227

1425400 323550 323700 323850 324000  
1425850 142550 142550 142550 1425400  
+ + + + +

| TECHNICAL DESCRIPTION |               |              |
|-----------------------|---------------|--------------|
| CORNER                | BEARING       | DISTANCE (m) |
| 1-2                   | S 65°18'53" W | 241.315      |
| 2-3                   | N 1°00' W     | 130          |
| 3-4                   | N 55°00' E    | 245          |
| 4-1                   | S 7°00' E     | 171          |

Tie line is N 84°52'54" W, 7852.176 meters from MRE-3247 (121°26'56.67264" Longitude, 12°5'6.72345" Latitude) to Corner 1.

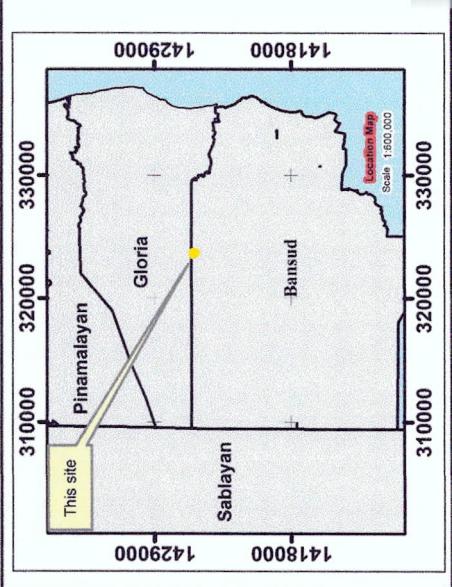

**CERTIFICATE OF STEWARDSHIP CONTRACT  
(CSC) NO. 028567**

**JOSE ILAO**

|                  |                             |
|------------------|-----------------------------|
| <b>LOCATION:</b> | Barangay : Conrrazon        |
|                  | Municipality : Bansud       |
|                  | Province : Oriental Mindoro |

Total Area : 3.31 Hectares

Scale 1:4,000  
Meridional  
Spheroid.....Clarke 1866  
Universal Transverse Mercator (Zone 5)  
Clarke 1866


| LEGEND           |  | Rivers and Creeks | Municipal Boundary |
|------------------|--|-------------------|--------------------|
| CSC Corner       |  |                   |                    |
| CSC Area         |  |                   |                    |
| CADC123 Boundary |  |                   |                    |


**CERTIFICATION**

This is to certify that this is the true and correct map of the areas under  
**CERTIFICATE OF STEWARDSHIP CONTRACT** (CSC) No. 028587 of  
Jose Iao as described herein.  
This map was prepared based on the submitted maps, documents and  
other references available from this office.

~~MINDORO PROJ. NO. 4 - H BLOCK - C  
APPROVED JANUARY 04, 1960, L.C. MAP NO. 2319~~

**References:**  
L.C. Map No. 2227

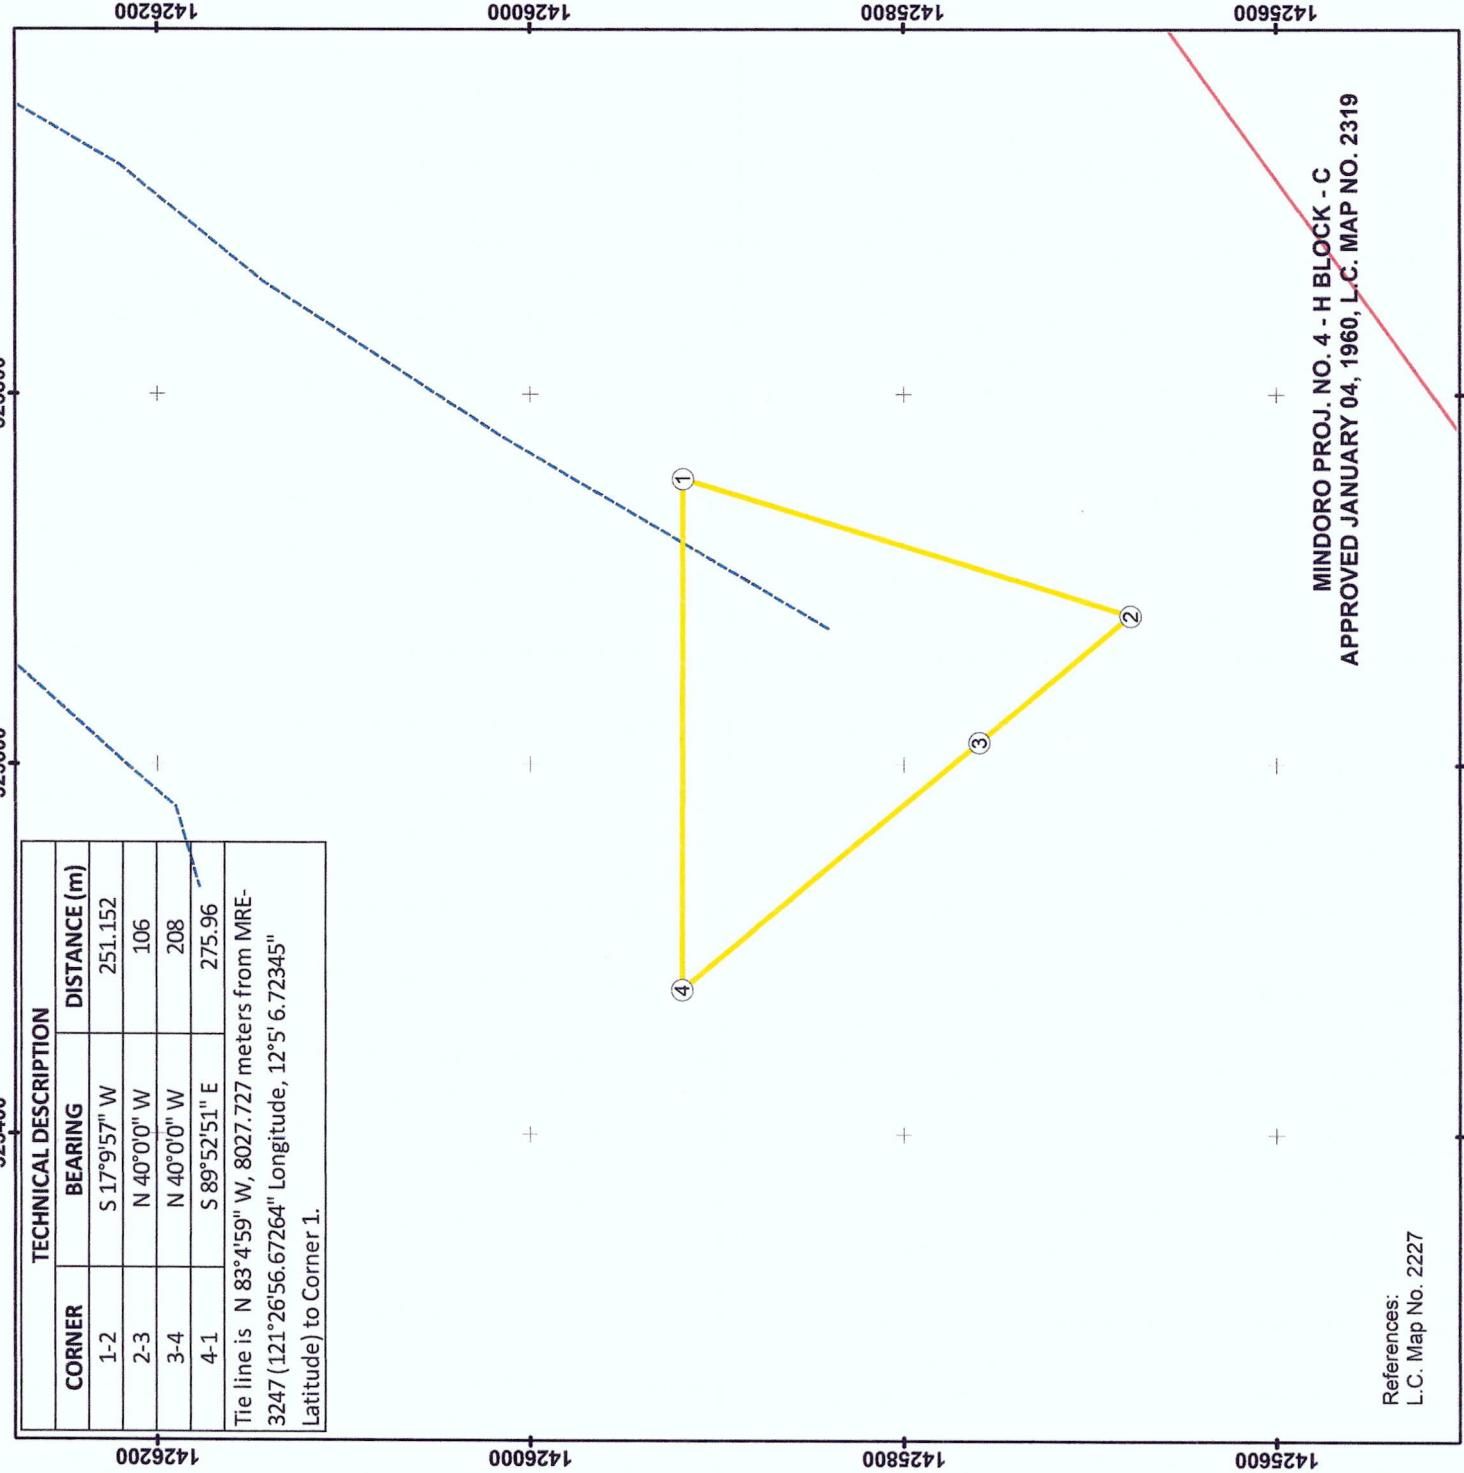

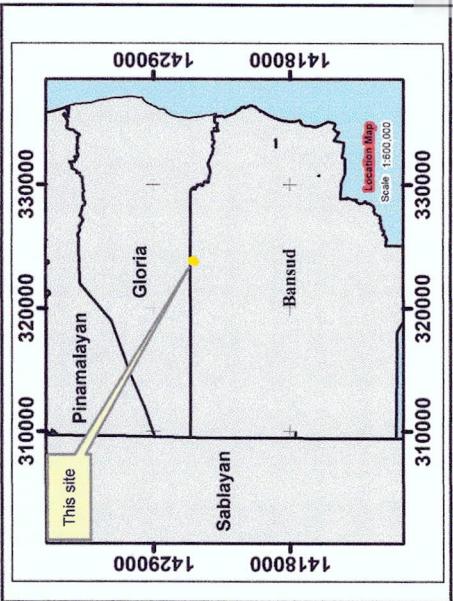

**CERTIFICATE OF STEWARDSHIP CONTRACT  
(CSC) NO. 028568  
OF**

**JOSE CASTILLO**

LOCATION:  
Barangay : Contrazon  
Municipality : Bansud  
Province : Oriental Mindoro

Total Area : 2.52 Hectares

Scale 1:3,000  
0 2,500 5,000 7,500 10,000  
Metres  
Spheroid: Clarke 1866  
Projection: Universal Transverse Mercator (Zone 51)  
Horizontal Datum: WGS 1984

**LEGEND**

- CSC Corner
- CSC Area
- CAD/CART Boundary
- Rivers and Creeks
- Municipal Boundary

NOTE: The political boundaries are not authoritative.



**CERTIFICATION**  
This is to certify that this is the true and correct map of the areas under  
CERTIFICATE OF STEWARDSHIP CONTRACT (CSC) No. 028568 of  
Jose Castillo as described herein.  
This map was prepared based on the submitted maps, documents and  
other references available from this office.


Prepared by:  
MARLON M. NGABIT  
Forester  
EBIM Desk Officer


**MINDORO PROJ. NO. 4 - H BLOCK - C  
APPROVED JANUARY 04, 1960, L.C. MAP NO. 2319**

References:  
L.C. Map No. 2227

Approved by:  
ENGR. CAESAR E. QUEBEC  
CEIR Officer

March 13, 2023  
March 15, 2023  
Date  
Date

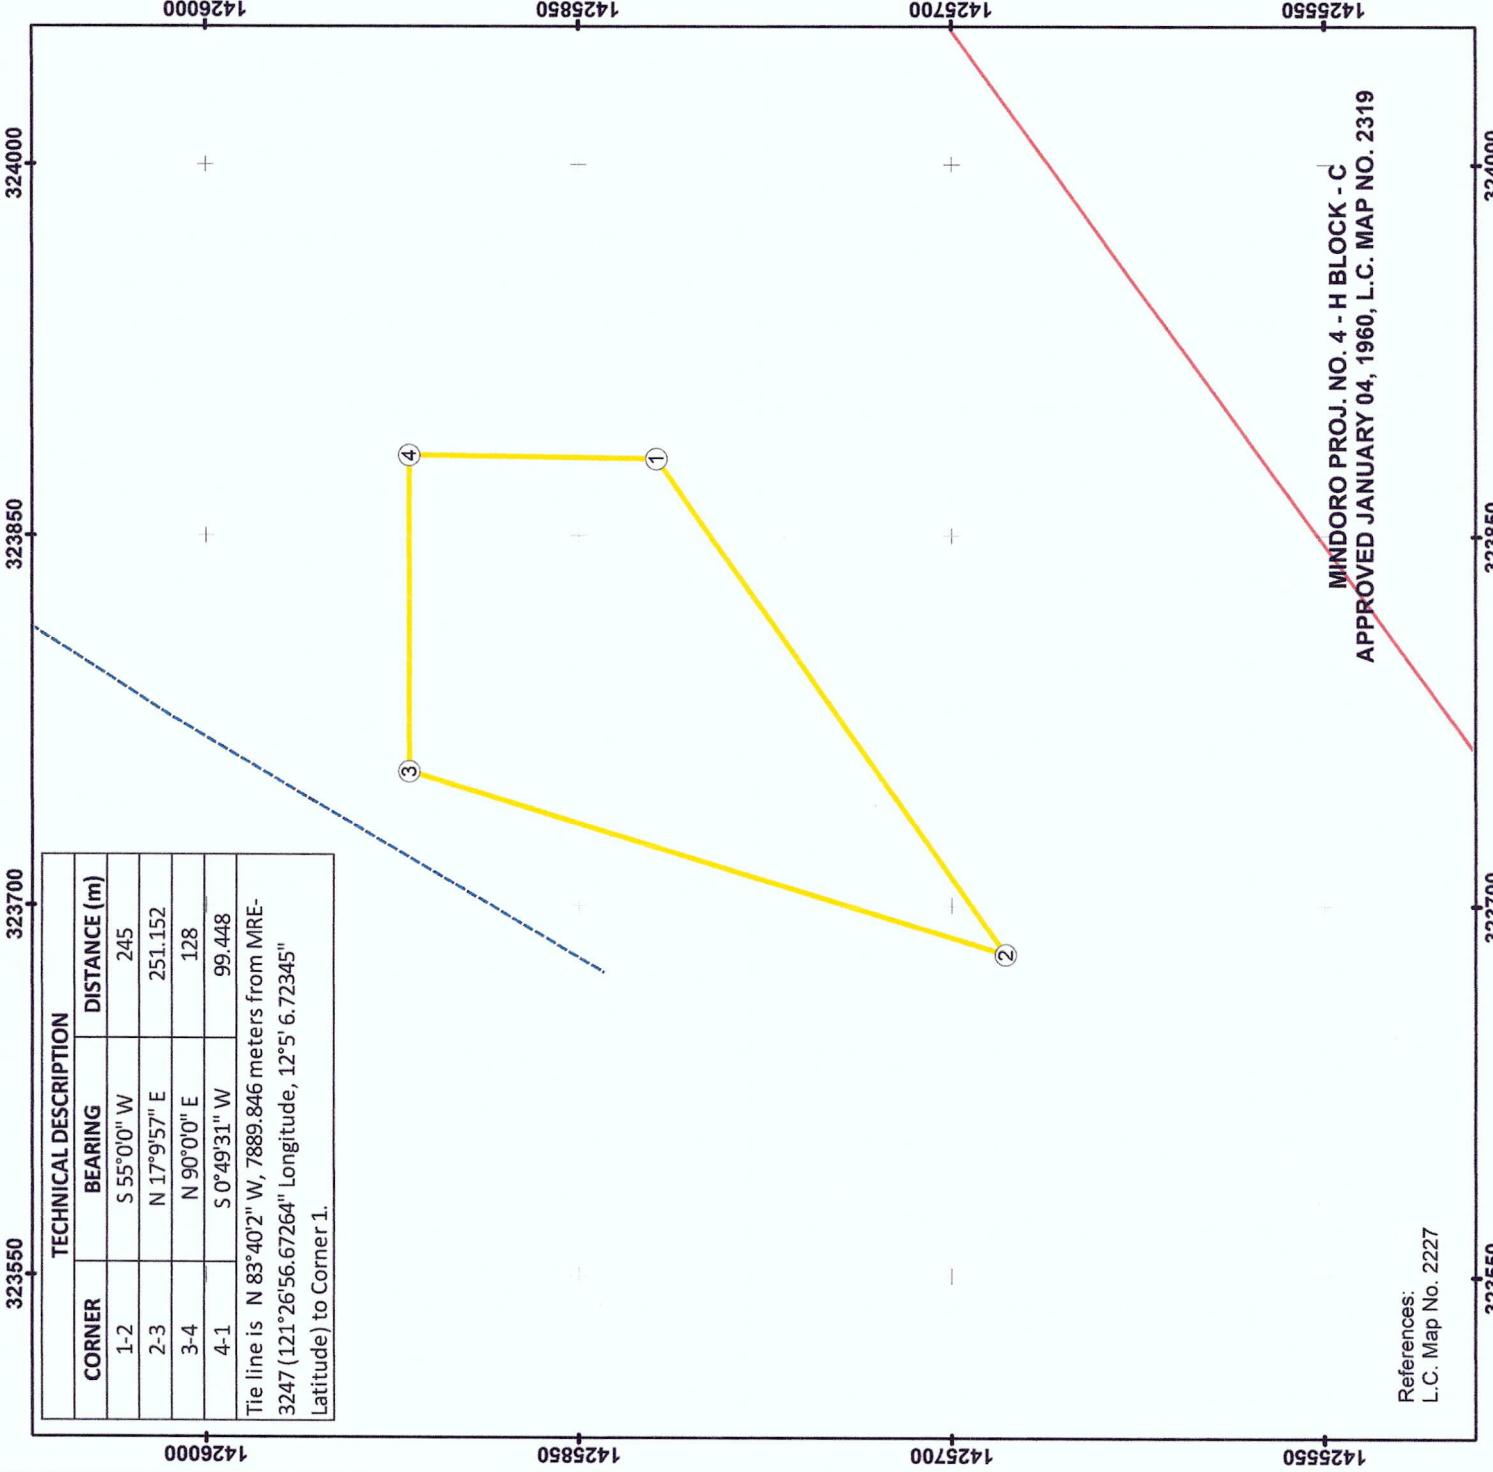

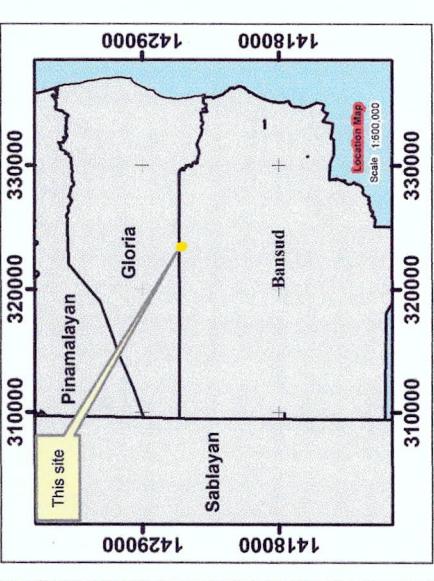

**CERTIFICATE OF STEWARDSHIP CONTRACT  
(CSC) NO. 028565  
OF**

**FLORENTINO MAGSINO**

LOCATION: Barangay : Contrazon  
Municipality : Bansud  
Province : Oriental Mindoro

Total Area : 2.18 Hectares

Scale 1:3,000

0 2,500 5,000 7,500 10,000  
Metres  
Spheroid.....Clark's 1866  
Projection.....Universal Transverse Mercator (Zone 51)  
Horizontal Datum.....WGS 1984

**LEGEND**

- CSC Corner
- CSC Area
- Rivers and Creeks
- Municipal Boundary

NOTE: The political boundaries are not authoritative.

Republic of the Philippines  
Department of Environment and Natural Resources  
MINAROPA Region  
Community Environment and Natural Resources Office  
San Mariano, Roxas, Oriental Mindoro

**CERTIFICATION**

This is to certify that this is the true and correct map of the areas under  
CERTIFICATE OF STEWARDSHIP CONTRACT (CSC) NO. 028565 of  
Florentino Magsino as described herein.  
This map was prepared based on the submitted maps, documents and  
other references available from this office.

Prepared by:  
  
MARIELEM. NGABIT  
Forester /BPM Desk Officer

Approved by:  
  
ENGR. CESARE. QUEBEC  
CENR Officer


MINDORO PROJ. NO. 4 - H BLOCK - C

APPROVED JANUARY 04, 1960, L.C. MAP NO. 2319

References:  
L.C. Map No. 2227

323250 323400 323550  
1425700 1425850 1426000 1426150  
323400 323550  
1425700 1425850 1426000 1426150

323250 323400 323550  
1425700 1425850 1426000 1426150  
323400 323550  
1425700 1425850 1426000 1426150

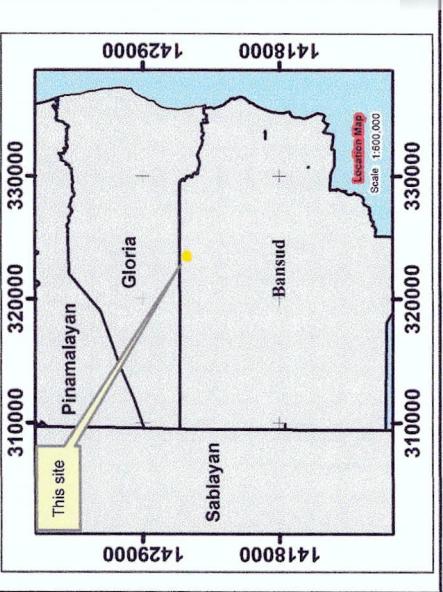

**CERTIFICATE OF STEWARDSHIP CONTRACT**  
(CSC) NO. 028573

**FIDELA DAVIS**

LOCATION: Barangay : Contrazon  
Municipality : Bansud  
Province : Oriental Mindoro

Total Area : 3.05 Hectares

Scale 1:3,000  
Spheroid: Clarke 1886  
Projection: Universal Transverse Mercator (Zone 51)  
Horizontal Datum: WGS 1984

**LEGEND**

- CSC Corner
- CSC Area
- CADC123 Boundary
- Rivers and Creeks
- Municipal Boundary



**CERTIFICATION**

This is to certify that this is the true and correct map of the areas under CERTIFICATE OF STEWARDSHIP CONTRACT (CSC) No. 028573 of Fideila Davis as described hereon.

This map was prepared based on the submitted maps, documents and other references available from this office.

Prepared by:  
**MARIELEN M. NGABIT**  
Forester /CBFM Desk Officer

Approved by:  
**GRACIELA E. OSEBEC**  
ENGR./CAESEAR E. OSEBEC  
DNR Officer


References:  
L.C. Map No. 2227


March 13, 2023

March 15, 2023

Date

Copyright 2023

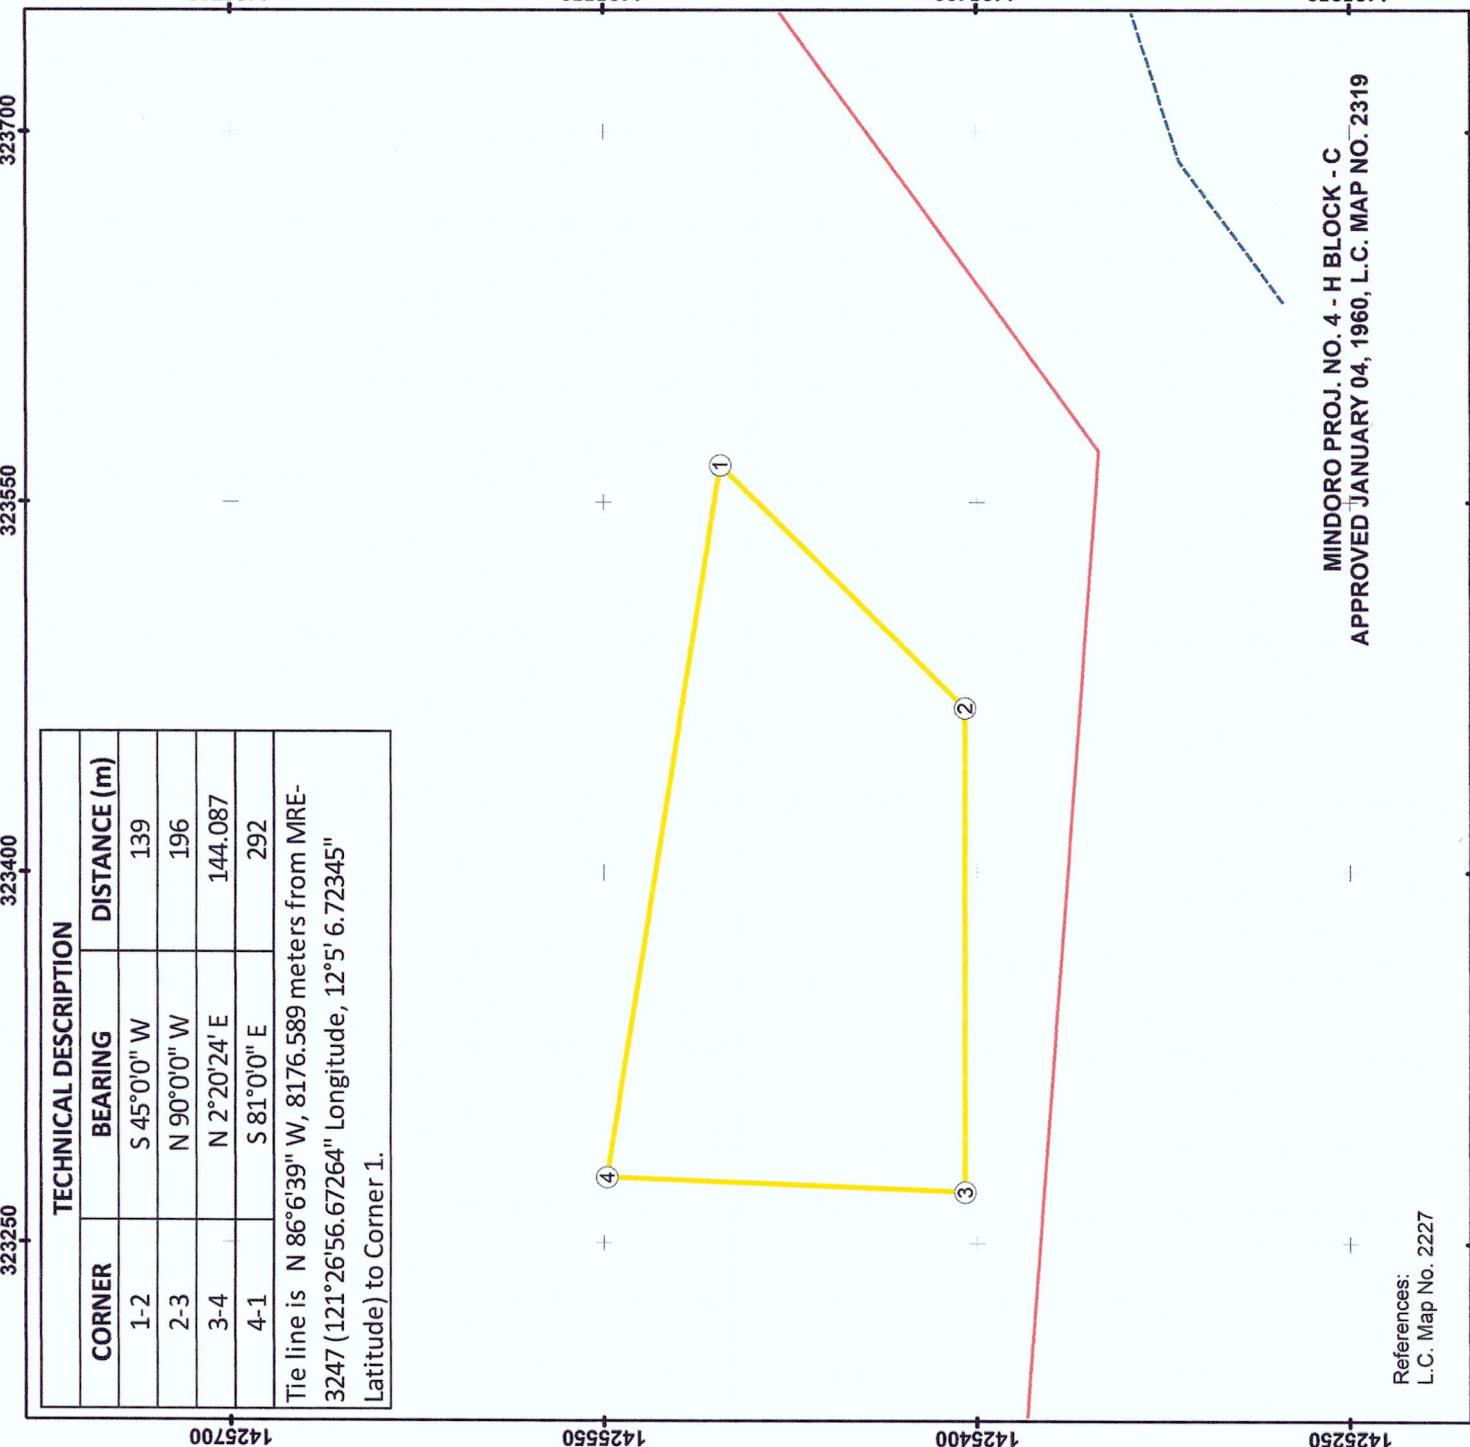

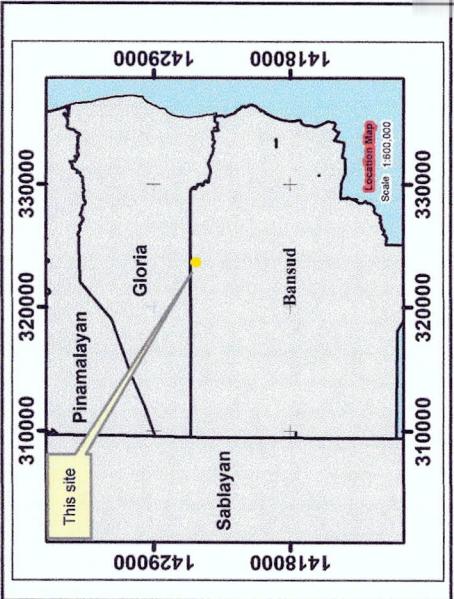

**CERTIFICATE OF STEWARDSHIP CONTRACT  
( CSC ) NO. 028570  
OF**

**ESTANISLAO RAVANO**

**LOCATION:** Barangay : Conrazon  
Municipality : Bansud  
Province : Oriental Mindoro

**Total Area :** 3.26 Hectares

Scale 1:3,000  
Spheroid..... Clarke 1866  
Projection..... Universal Transverse Mercator Zone 51  
Horizontal Datum..... WGS 1984

**LEGEND**

- CSC Corner
- CSC Area
- CADC123 Boundary
- Municipal Boundary

NOTE: The political boundaries are not authoritative.



Republic of the Philippines  
Department of Environment and Natural Resources

MIMAROPA Region  
Community Environment and Natural Resources Office


San Mariano, Roxas, Oriental Mindoro


**CERTIFICATION**  
This is to certify that this is the true and correct map of the areas under  
CERTIFICATE OF STEWARDSHIP CONTRACT ( CSC ) No. 028570 of  
Estanislao Ravano as described hereon.  
This map was prepared based on the submitted maps, documents and  
other references available from this office.

Prepared by:  
**MAREZ M. NGABIT**  
Forester/MCBFM Desk Officer  
March 13, 2023

Approved by:  
**Quintillio  
ENGR. CAESAR E. QUEBEC**  
CENR Officer  
March 15, 2023

Copyright 2023

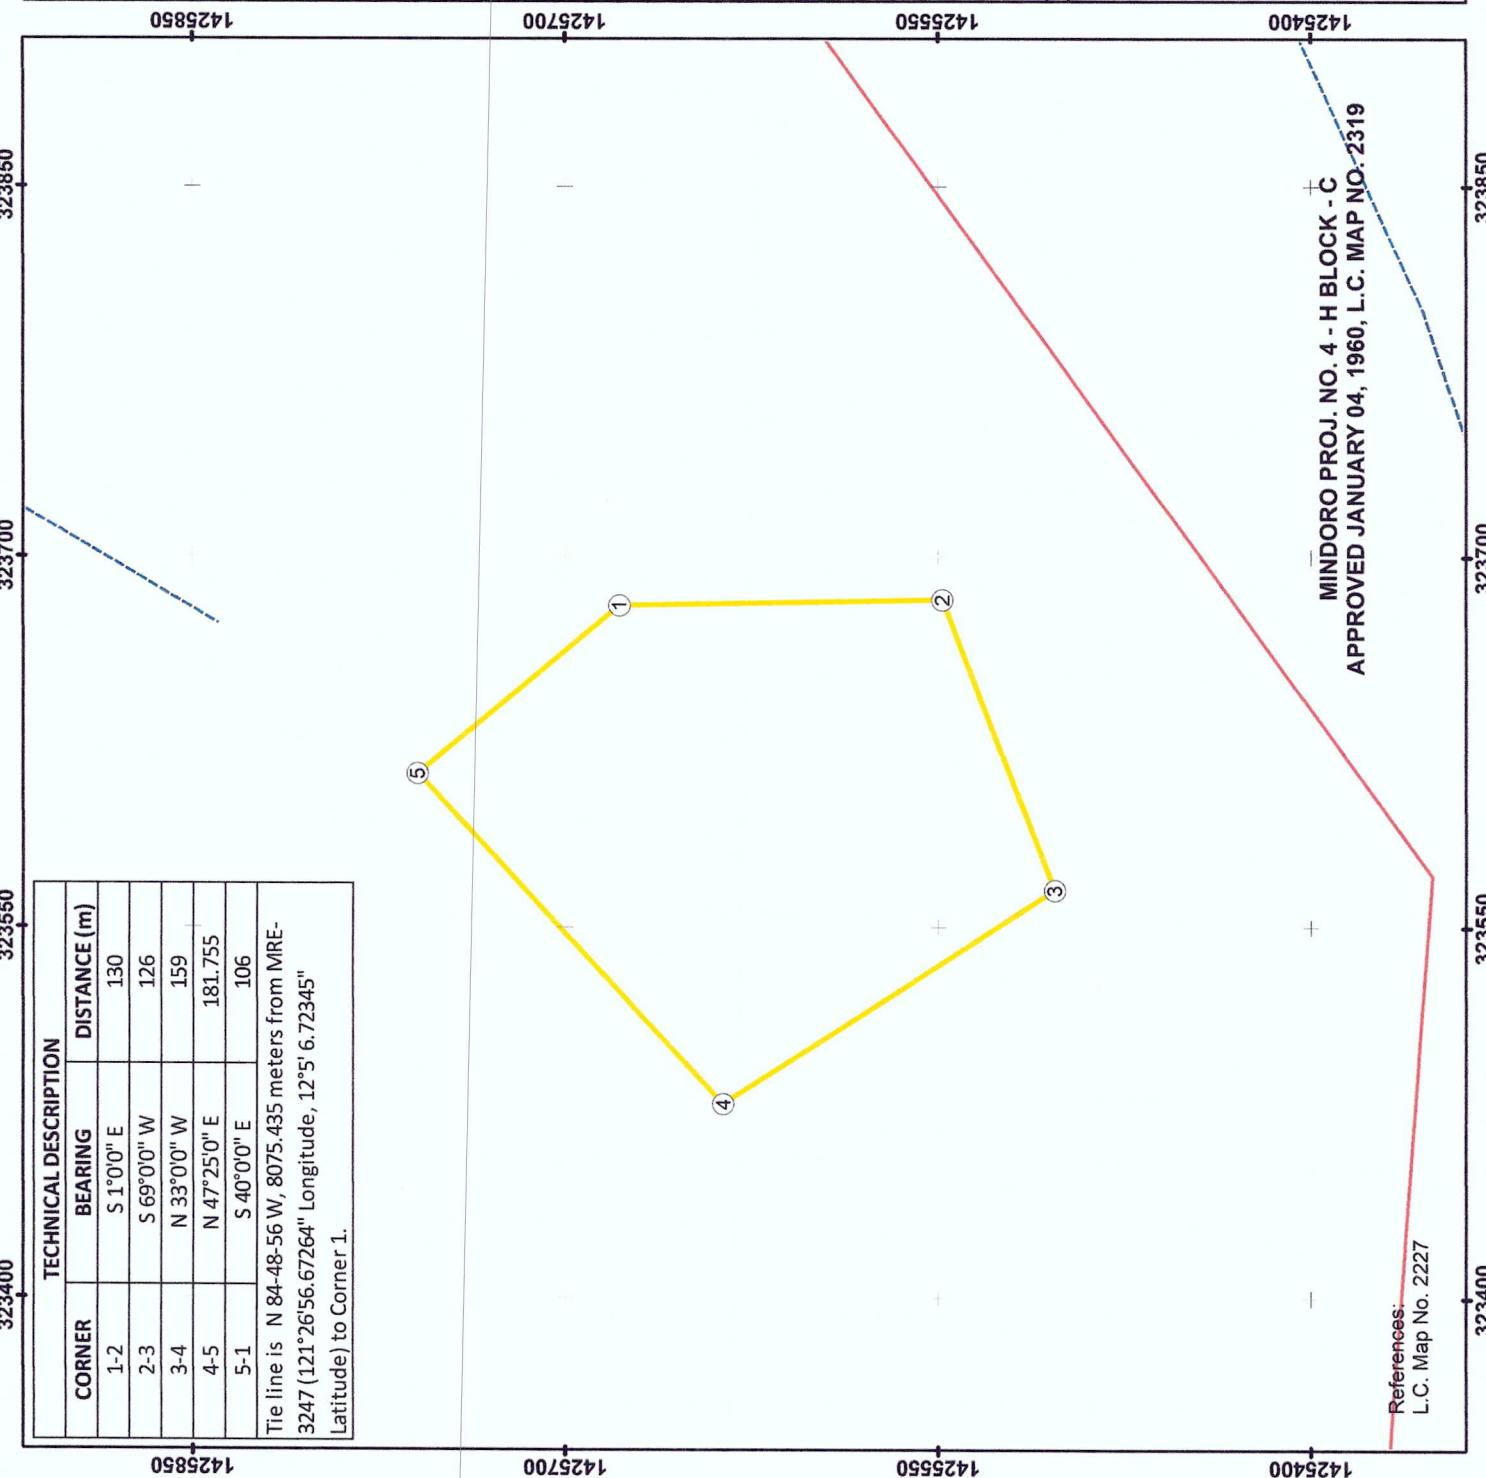

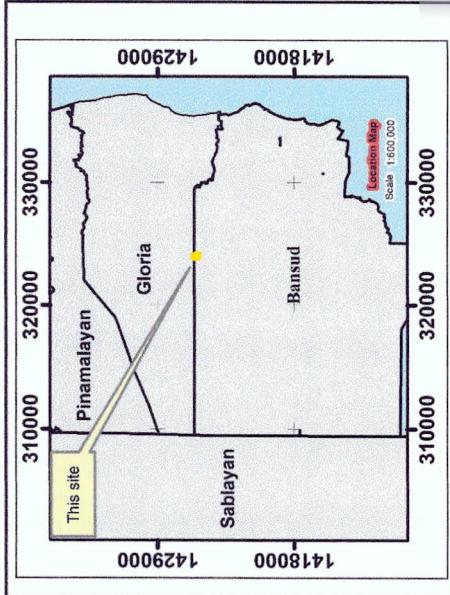

**CERTIFICATE OF STEWARDSHIP CONTRACT  
( CSC ) NO. 028560  
OF**

**DELFIN MAGADIA**

**LOCATION:** Barangay : Conrazon  
Municipality : Bansud  
Province : Oriental Mindoro


**Total Area : 2.90 Hectares**

Scale 1:3,000  
0 2400 4800 7200 9600  
Metres  
Spheroid.....Clarke 1866  
Projection.....Universal Transverse Mercator (Zone 51)  
Horizontal Datum.....WGS 1984

**LEGEND**

- CSC Corner
- CSC Area
- CAD/CADD Boundary
- Rivers and Creeks
- Municipal Boundary

NOTE: The political boundaries are not authoritative

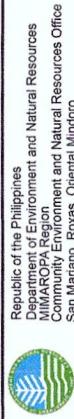

**CERTIFICATION**

This is to certify that this is the true and correct map of the areas under CERTIFICATE OF STEWARDSHIP CONTRACT ( CSC ) No. 028560 of Delfin Magadia as described herein.

This map was prepared based on the submitted maps, documents and other references available from this office.

Prepared by:

*[Signature]*  
**MARIELLE M. NGABIT**  
Forester/NCBFM Desk Officer

March 13, 2023  
Date

ENGR. CAESAR E. DEBEC  
ENR Officer



March 15, 2023  
Date


References:  
L.C. Map No. 22227

**MINDORO PROJ. NO. 4 - H BLOCK - C  
APPROVED JANUARY 04, 1960, L.C. MAP NO. 2319**

324200

Copyright 2023

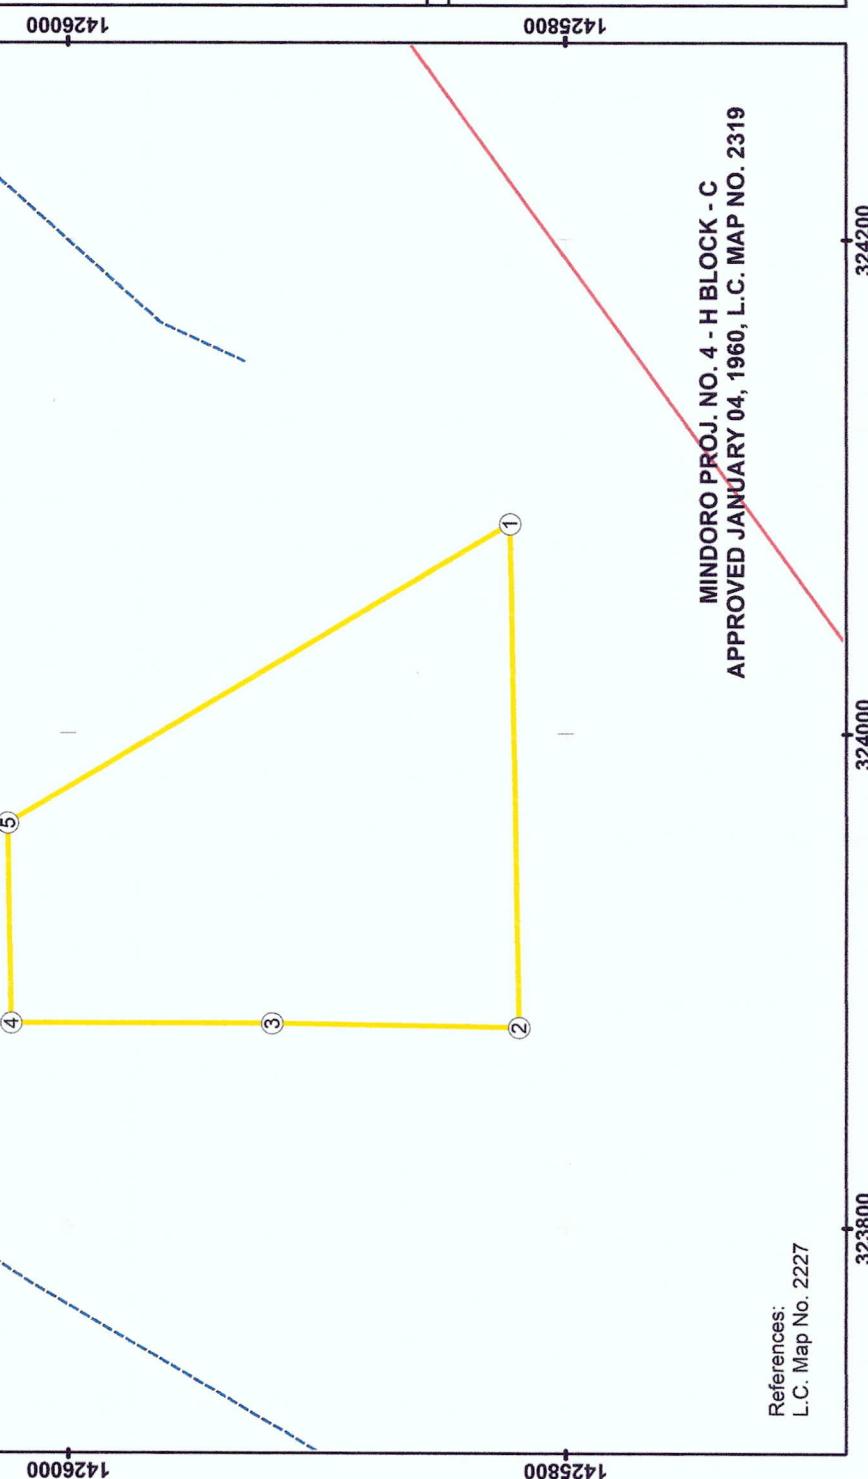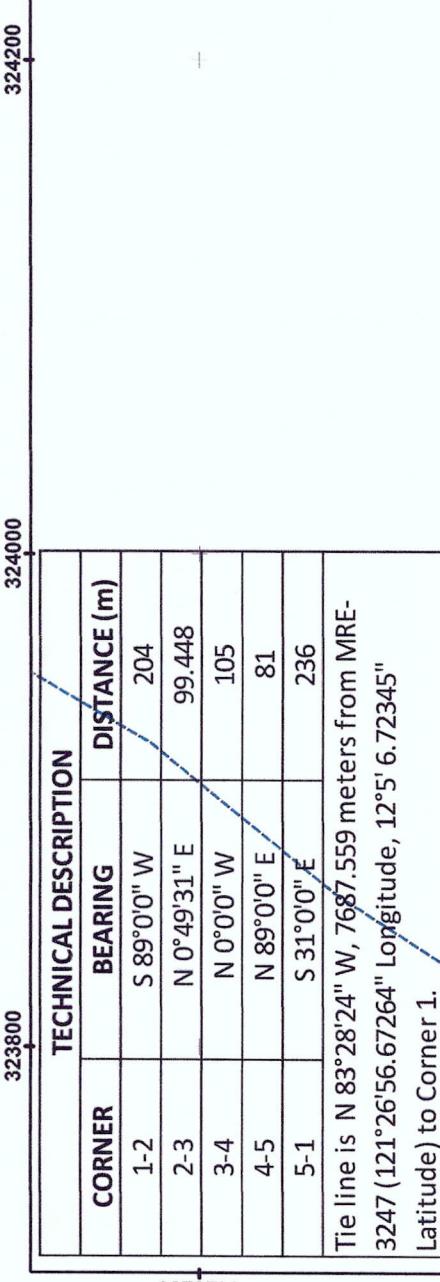

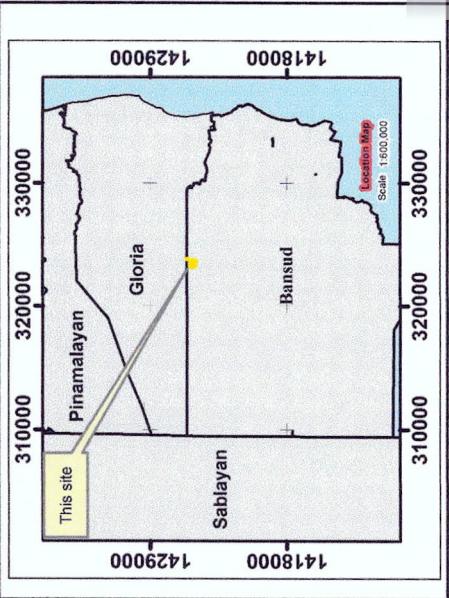

CERTIFICATE OF STEWARDSHIP CONTRACT

(CSC) NO. 028561  
OF

**BEN CASTILLO**

LOCATION: Barangay : Contrazon  
Municipality : Bansud  
Province : Oriental Mindoro

Total Area : 2.87 Hectares

Scale 1:3,000  
0 2.65 5.30 10.50 15.750 21.000  
Spheroid: Clarke 1866  
Projection: Universal Transverse Mercator Zone 51  
Horizontal Datum: WGS 1984

LEGEND

- CSC Corner
- CSC Area
- Rivers and Creeks
- Municipal Boundary

NOTE: The political boundaries are not authoritative.

Republic of the Philippines  
Department of Environment and Natural Resources  
MIMAROPA Region  
Community Environment and Natural Resources Office  
San Mariano, Roxas, Oriental Mindoro

**CERTIFICATION**

This is to certify that this is the true and correct map of the areas under CERTIFICATE OF STEWARDSHIP CONTRACT (CSC) No. 028561 of Ben Castillo as described hereon.

This map was prepared based on the submitted maps, documents and other references available from this office.

Prepared by:  
*Marielene M. Ngabit*  
Forester  
BFRM Desk Officer

March 13, 2023

March 15, 2023

Approved by:  
*Engr. Caesar E. Quisec*  
ENGR. CAESAR E. QUISEC  
CENR Officer


March 15, 2023


References:  
L.C. Map No. 2227

324000

323800

323600

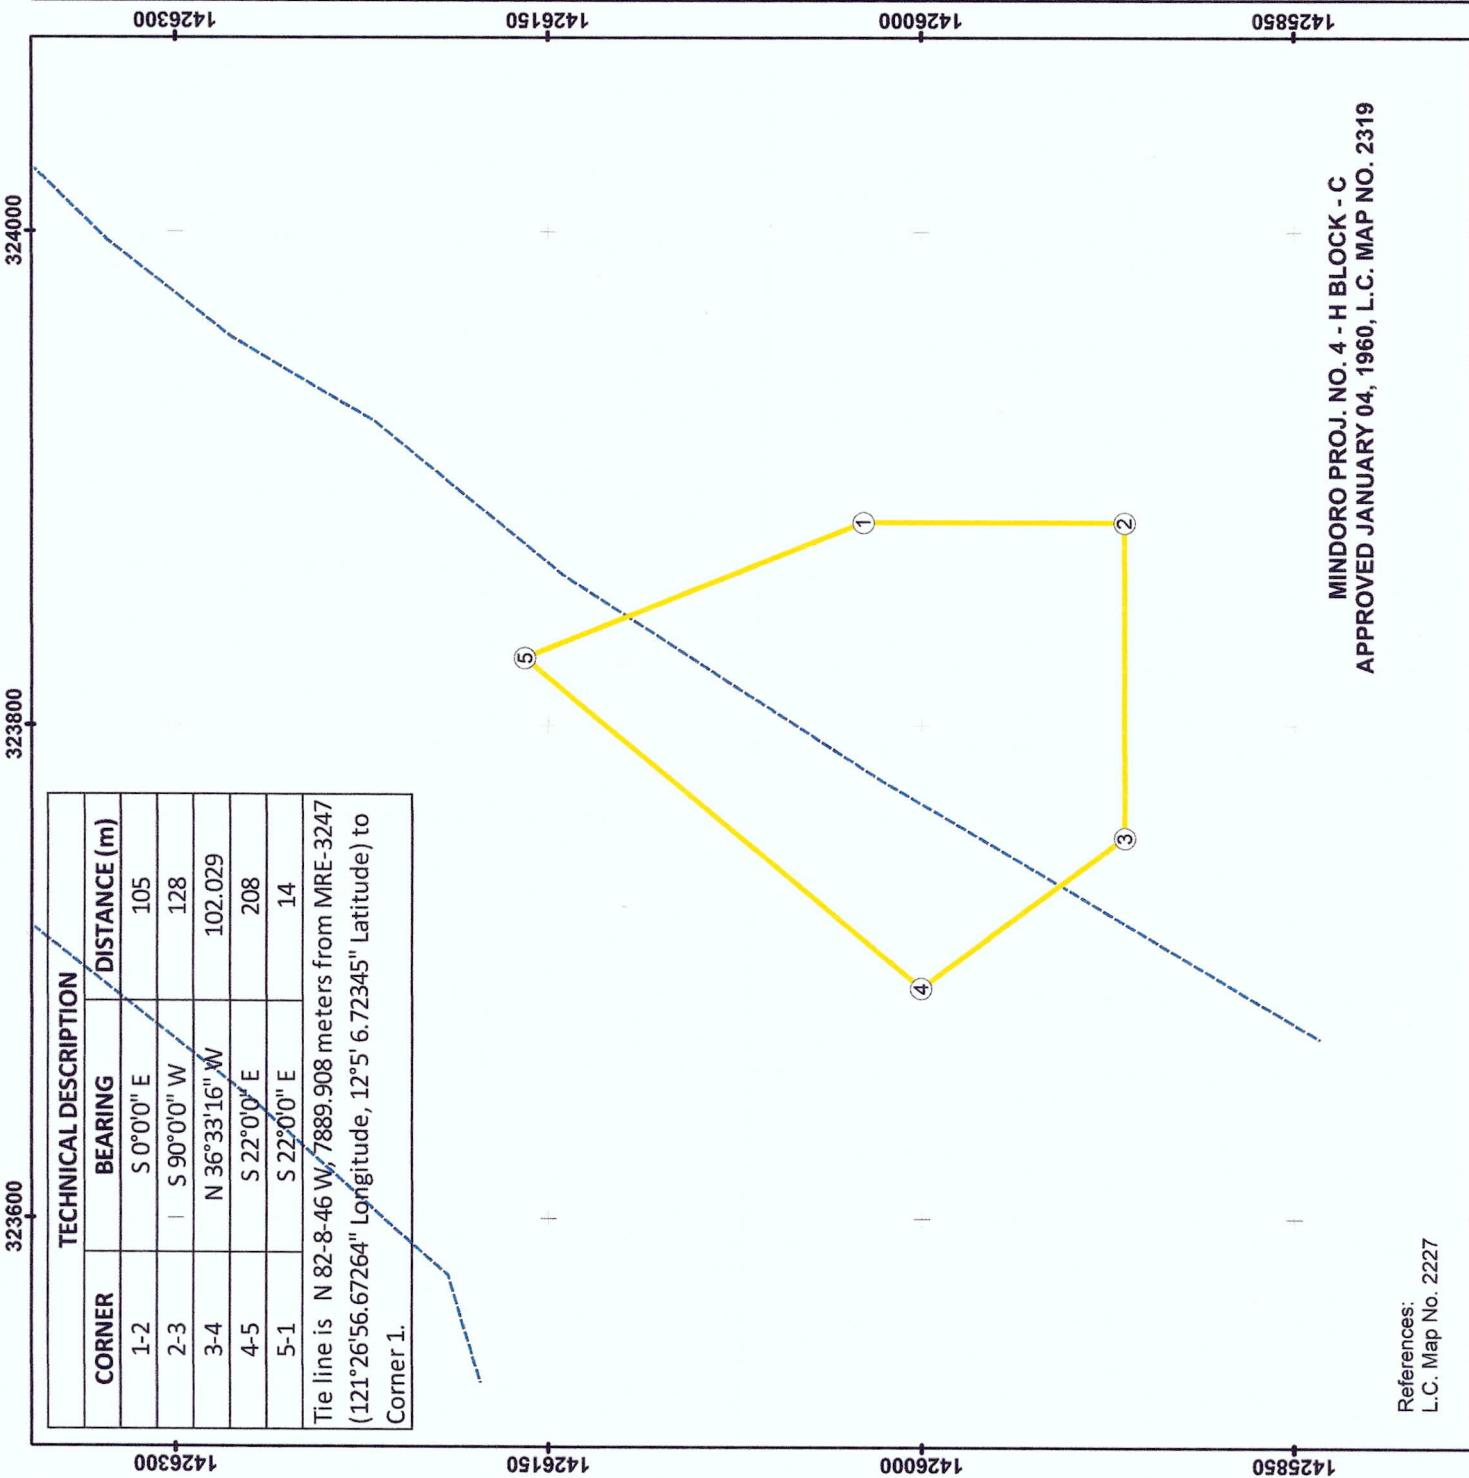

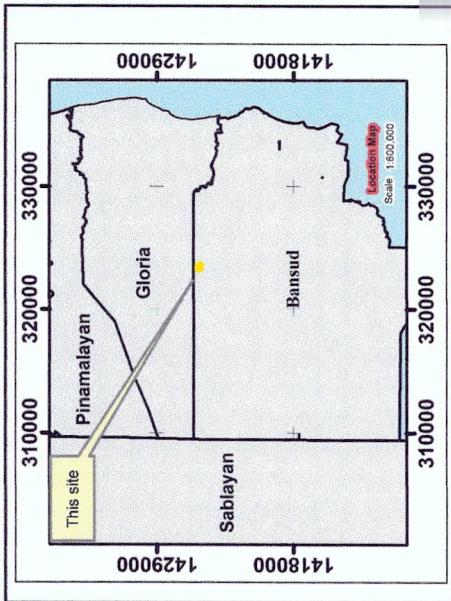

CERTIFICATE OF STEWARDSHIP CONTRACT  
(CSC) NO. 028572  
OF

**AURORA PALMA**

LOCATION: Barangay : Conrazon  
Municipality : Bansud  
Province : Oriental Mindoro

Total Area : 2.63 Hectares

Scale 1:3,000  
0 2,420 4,840 7,260 9,680 12,100 14,520 16,940 21,360  
Metres  
Sphereid..... Clarke 1866  
Projection..... Universal Transverse Mercator (Zone 51)  
Horizontal Datum..... WGS 1984

LEGEND  
○ CSC Corner  
■ CSC Area  
□ CADC123 Boundary  
Rivers and Creeks  
Municipal Boundary

NOTE: The political boundaries are not authoritative



**CERTIFICATION**

This is to certify that this is the true and correct map of the areas under CERTIFICATE OF STEWARDSHIP CONTRACT (CSC) No. 028572 of Aurora Palma as described herein.  
This map was prepared based on the submitted maps, documents and other references available from this office.

Prepared by:  
*MARIE LIZZ M. NGABIT*  
Forester /EBFM Desk Officer

Approved by:  
*OMAR E. QUEBEC*  
ENGR. /CENR Officer


References:  
L.C. Map No. 2227

1425400  
323600

323400  
142550

323200  
1425850

March 13, 2023  
March 15, 2023  
Date  
Copyright 2023

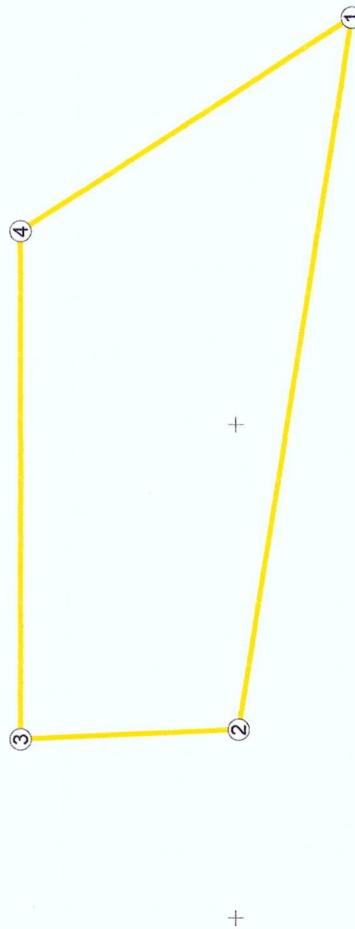

| TECHNICAL DESCRIPTION |              |              |
|-----------------------|--------------|--------------|
| CORNER                | BEARING      | DISTANCE (m) |
| 1-2                   | N 81°00' W   | 292          |
| 2-3                   | N 2°44'17" W | 87.77        |
| 3-4                   | N 90°00' E   | 206          |
| 4-1                   | S 33°00' E   | 159          |

Tie line is N 86°6'39" W, 8176.589 meters from MRE-3247 (121°26'56.67264" Longitude, 12°5' 6.72345" Latitude) to Corner 1.

323600  
323400

1425400

142550  
1425700  
1425850

1425400  
323400

323600  
1425400

**MINDORO PROJ. NO. 4 - H BLOCK-C**  
**APPROVED JANUARY 04, 1960, L.C. MAP NO. 2319**